

ALASKA NATIVE CLAIMS SETTLEMENT ACT (ANCSA) SECTION 14 (C) TRACTS I THROUGH 12 P.L. 92-203, (85 STAT. 688, 702, 703)

HUNA TOTEM CORPORATION AT HOONAH, ALASKA AND

THE DEPENDENT RESURVEY OF THE SOUTH BOUNDARY AND THE RETRACEMENT OF THE EAST BOUNDARY OF T. 43 S., R. 61 E., C.R.M., THE DEPENDENT RESURVEY OF PORTIONS OF U.S. SURVEY Nos. 1899, 1929, 2124, 2414, 2595, 4539 AND THE RETRACEMENT OF ALASKA TIDELANDS SURVEY No. 1261.

This plat contains the entire survey record.

This survey was executed by Kristine S. Ogonowski, Alaska Registered Land Surveyor, No. 8536, for Huna Totem Corporation, June 4 through July 27, 2005, in accordance with the principles set forth in the Manual of Surveying Instructions, 1973; Special Instructions approved February 14, 2005, Amended Special Instructions approved April 6, 2005; Huna Totem Corporation ANCSA 14(c) Map of Boundaries, accepted November 12, 2003; Contract No. NAA050008, awarded May 31, 2005, and Notice to Proceed dated June 3, 2005.

Field Assistants were:

- Richard L. Gaffey, LSIT, Party Chief
Jeffery S. Hsu, Survey Technician
Bryce M. Withers, Survey Technician

Area: 1181.98 Acres

The azimuth was determined by Global Positioning Systems using static relative positioning techniques, and refers to the true meridian. The directions of all lines are mean bearings.

The geographic position of the southeast corner of T. 43 S., R. 61 E., Copper River Meridian, as taken from the record plat accepted April 1, 1980, is:

Latitude: 58° 05' 27.67" North NAD 27
Longitude: 135° 20' 54.01" West

The mean magnetic declination was obtained from direct field observations.

This survey is situated in and around the City of Hoonah, Alaska, within Townships 43 South, Ranges 61 and 62 East, Copper River Meridian, Alaska.

The terrain throughout this survey varies from flat in the tidelands to steep mountainous slopes. The timber is mature forest of spruce and hemlocks, with an understory of devil's club, berry bushes and ferns. Forest duff lies over layers of organic loam, rocky mineral soil and bedrock.

UNITED STATES DEPARTMENT OF THE INTERIOR BUREAU OF LAND MANAGEMENT Anchorage, Alaska

The survey represented by this plat, having been correctly executed in accordance with the requirements of law and the regulations of this Bureau, is hereby accepted.

For the Director

John S. [Signature] 12/5/06 Date

Deputy State Director for Cadastral Survey, Alaska

HISTORY OF SURVEYS

The boundaries of Ts. 43 S., Rs. 61 and 62 E., Copper River Meridian, were surveyed by Mason W. Thayer and Malcolm F. McCone, Cadastral Surveyors, in 1974 through 1976.

Certain corners of the south boundary of T. 43 S., R. 61 E., Copper River Meridian, were recovered by Kristine Staffeldt Ogonowski, Alaska Registered Land Surveyor No. 8536, in 1999.

U.S. Survey No. 1929 was surveyed by E. C. Guerin, Cadastral Engineer, in 1929.

U.S. Survey No. 1899 was surveyed by E. C. Guerin, Cadastral Engineer, in 1930.

U.S. Survey No. 2124 was surveyed by Chas. P. Seelye, U.S. Transitman, in 1932.

U.S. Survey No. 2414 was surveyed by F. W. Williamson, Cadastral Engineer and Leonard M. Berlin, Surveyor, in 1938.

U.S. Survey No. 2414A, based entirely upon the record of U.S. Survey No. 2414, was accepted January 31, 1980.

U.S. Survey No. 2595 was surveyed by F. W. Williamson, Assoc. Cadastral Engineer, in 1941.

U.S. Survey No. 4539 was surveyed by Clifford L. McKay, Supervisory Cadastral Surveyor, in 1962.

U.S.F.S. - Tongass - A Neck Point Residence Group Spasski Bay - Chichagof Island was surveyed by Blackerby, Zach and Maycock, of the U.S. Forest Service, in 1947, approved November 21, 1947 by the Asst. Regional Forester, not recorded.

Alaska Tidelands Survey No. 29, was surveyed by C.R. Nordling, Alaska Registered Engineer No. 777, in 1963.


Alaska Tidelands Survey No. 1261, Plat No. 85-38, Sitka Recording District, was surveyed by R.J. Hungerford, Alaska Registered Land Surveyor No. 5453, for the Department of Transportation and Public Facilities, in 1980 through 1985.

Alaska Tidelands Survey No. 1569, Plat No. 2003-20, Sitka Recording District, was surveyed by Thomas M. Kirchner, Alaska Registered Land Surveyor No. 5713, in 1998 through 1999.

The Record Survey of Lot 3, Neck Point Residence Group, Plat No. 2003-16, Sitka Recording District, was surveyed by Douglas Finley, Alaska Registered Land Surveyor No. 6277, in 2002.

Table of Contents

Table with 2 columns: Sheet number and Description. Includes Index, Rectangular Survey and Diagram, Rectangular Monument Descriptions, Sheet 2 Details, Sheet 2 Detail Monument Descriptions, Tract 3, Tracts 7 and 8, Tracts 7, 8, and 9 Monument Descriptions, Tracts 9, 10, 12 and A.T.S., Tracts 9, 10, 12 and A.T.S. Mon Descriptions, Tracts 1 and 2.

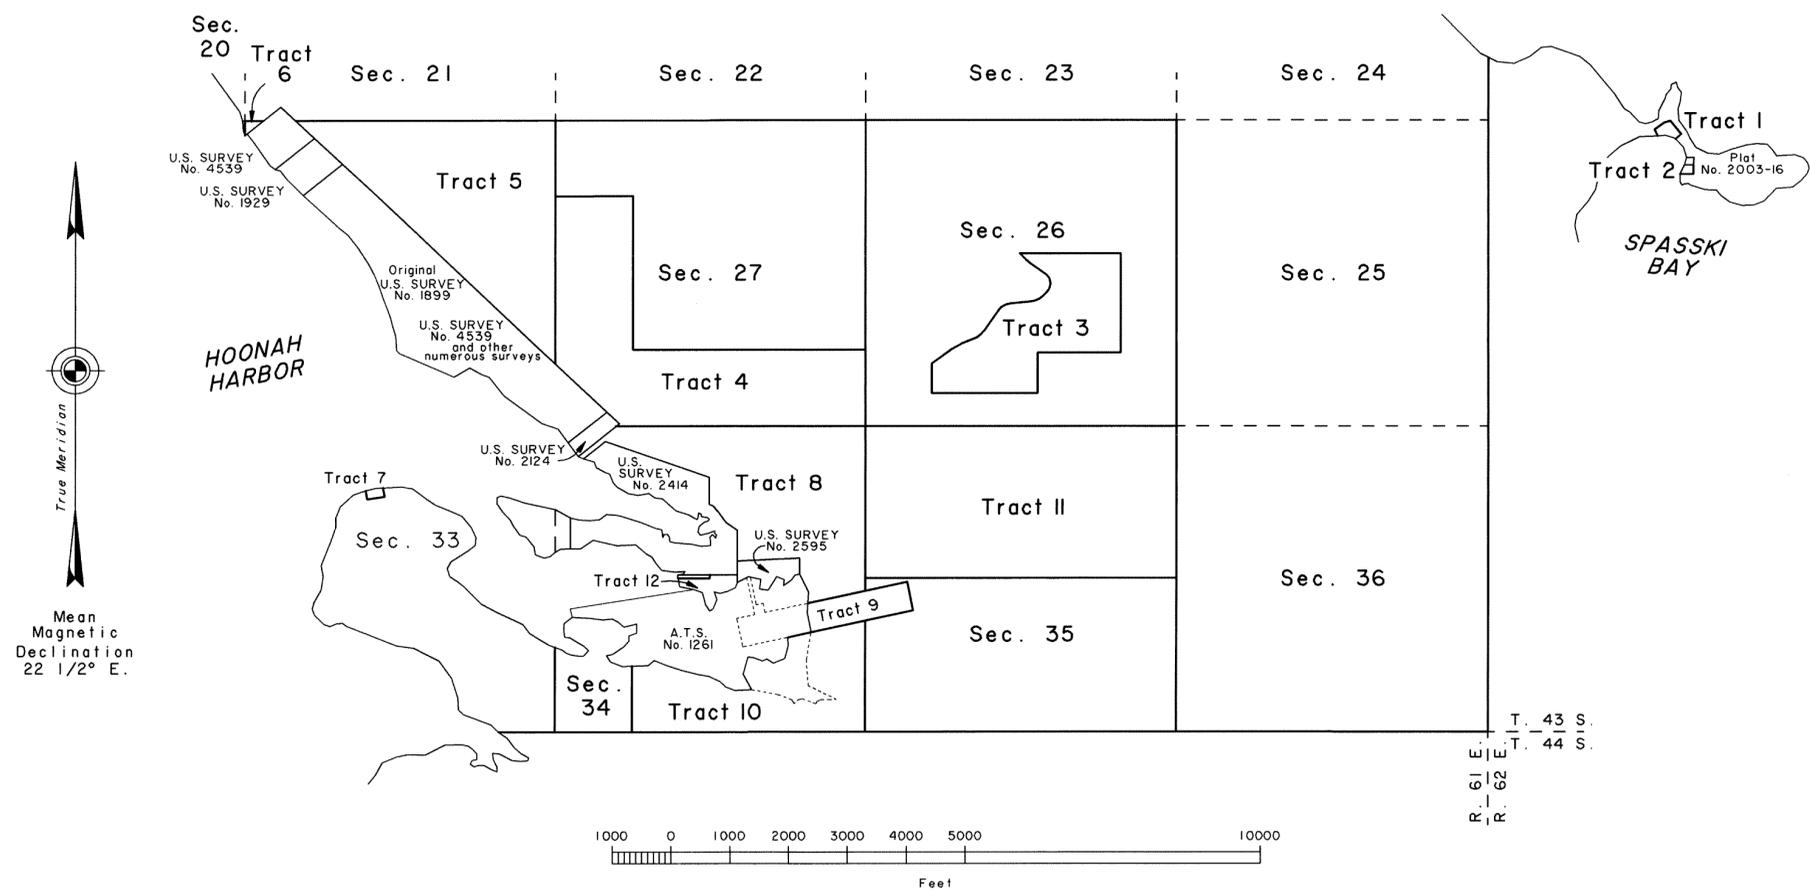

I, Kristine S. Ogonowski, Alaska Registered Land Surveyor No. 8536, for Huna Totem Corporation, HEREBY CERTIFY that I have executed the ANCSA 14(c) Survey depicted on this plat (sheets 1 through 11) in conformance with the Special Instructions, approved February 14, 2005, Amended Special Instructions, approved April 6, 2005, Contract No. NAA050008, awarded May 31, 2005, the principles of survey described in the Manual of Instructions for the Survey of the Public Lands of the United States, 1973, and in the specific manner described on this plat.



I hereby certify that the tracts represented on this plat of survey are on lands patented to Huna Totem Corporation by patent Nos. 50-89-0539 and 50-90-0299, issued by the United States of America. This survey accurately describes the lands intended to be conveyed pursuant to the requirements of ANCSA 14(c)(1), (3) and (4), and by statutory quit claim deed in settlement of claims recorded March 4, 1983, Book 59, Pages 581 through 583, Sitka Recording District. Said tracts also fulfill all entitlements under the provisions of ANCSA 14(c), as requested by Huna Totem Corporation and the Hoonah Map of Boundaries, accepted November 12, 2003.

October 19, 2006 Date Kristine S. Ogonowski Alaska Registered Land Surveyor

Jan 30 2006 Date [Signature] President, Huna Totem Corporation

ALASKA NATIVE CLAIMS SETTLEMENT ACT (ANCSA) SECTION 14 (C) TRACTS 1 THROUGH 12 P.L. 92-203, (85 STAT. 688, 702, 703)

HUNA TOTEM CORPORATION

AT HOONAH, ALASKA AND


THE DEPENDENT RESURVEY OF THE SOUTH BOUNDARY AND THE RETRACEMENT OF THE EAST BOUNDARY OF T. 43 S., R. 61 E., C.R.M., THE DEPENDENT RESURVEY OF PORTIONS OF U.S. SURVEY Nos. 1899, 1929, 2124, 2414, 2595, 4539 AND THE RETRACEMENT OF ALASKA TIDELANDS SURVEY No. 1261.

REFERENCE SHOULD BE MADE TO SHEET No. 1 FOR SURVEY INFORMATION

CROSS SOUND

- NOTES**
- Section corners of sections 26, 27, 34 and 35 were established using two-point control.
  - The position of section corner of sections 27, 28, 33, and 34 was calculated to create positions for the quarter corners and thereby the center quarter corner of section 34.
  - The letters "I" and "O" were not be used to identify monuments on this sheet.
  - Monument identifiers represent the sheet on which the monument description is located.

- LEGEND**
- Found BLM/GLO Monument
  - Set Monument This Survey
  - Set 5/8" Diam. Rebar This Survey
  - Found Primary Monument by Others

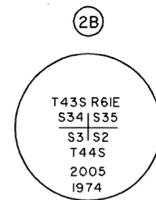

Found an alum. post, 2 1/2 ins. diam., firmly set, projecting 6 in. above ground, with an alum. cap mkd. as shown, from which the original bearing trees

A hemlock snag, 10 ins. diam., bears N. 52° E., 4.7 ft. dist., with scribe mks. T43S R61E S35 BT visible in a partially healed blaze.

A hemlock, 8 ins. diam., bears S. 30 1/2° E., 32.0 ft. dist., with scribe mks. T44S R61E S2 BT visible in a partially healed blaze. (Record: S. 40° E.)

A hemlock snag, 11 ins. diam., bears S. 58° W., 16.4 ft. dist., with scribe mks. T44S R61E S3 BT visible in a partially healed blaze.


A hemlock, 17 ins. diam., bears N. 3° W., 9.4 ft. dist., with scribe mks. T43S R61E S34 BT visible in a partially healed blaze.

and new bearing trees


A hemlock, 18 ins. diam., bears N. 62 1/2° E., 34.9 ft. dist., mkd. T43S R61E S35 BT.

A hemlock, 5 ins. diam., bears S. 59 3/4° W., 20.5 ft. dist., mkd. X BT.

Add the mks. 2005 to the alum. cap.

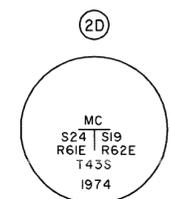

Found an alum. post, 2 1/2 ins. diam., firmly set, projecting 1 in. above ground, encircled by a collar of stone, 12 ins. diam., with an alum. cap mkd. as shown, from which the original bearing trees

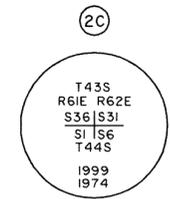

Found an alum. post, 2 1/2 ins. diam., firmly set, projecting 9 in. above ground, with an alum. cap mkd. as shown, from which the remaining 1974 bearing trees


A cedar, 8 ins. diam., bears S. 44° E., 19.4 ft. dist., with scribe mks. T44S R62E S6 visible in a partially healed blaze.

A cedar, 10 ins. diam., bears S. 30° W., 27.0 ft. dist., with a completely healed blaze.

A lodgepole pine, 9 ins. diam., bears N. 65 1/2° W., 16.4 ft. dist., with scribe mks. X BT visible in a partially healed blaze. (Record: spruce)

and the 1999 bearing tree



A cedar, 13 ins. diam., bears N. 76° E., 18.8 ft. dist., with scribe mks. T43S R62E S31 BT visible in a partially healed blaze.

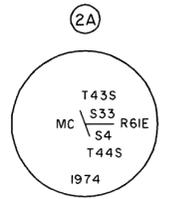

Found an alum. post, 2 1/2 ins. diam., firmly set, flush with the ground, with an alum. cap mkd. as shown, from which the original bearing trees

A spruce, 18 ins. diam., bears N. 29° E., 28.6 ft. dist., with a completely healed blaze.

A hemlock, 14 ins. diam., bears S. 58° E., 61.1 ft. dist., with a completely healed blaze.

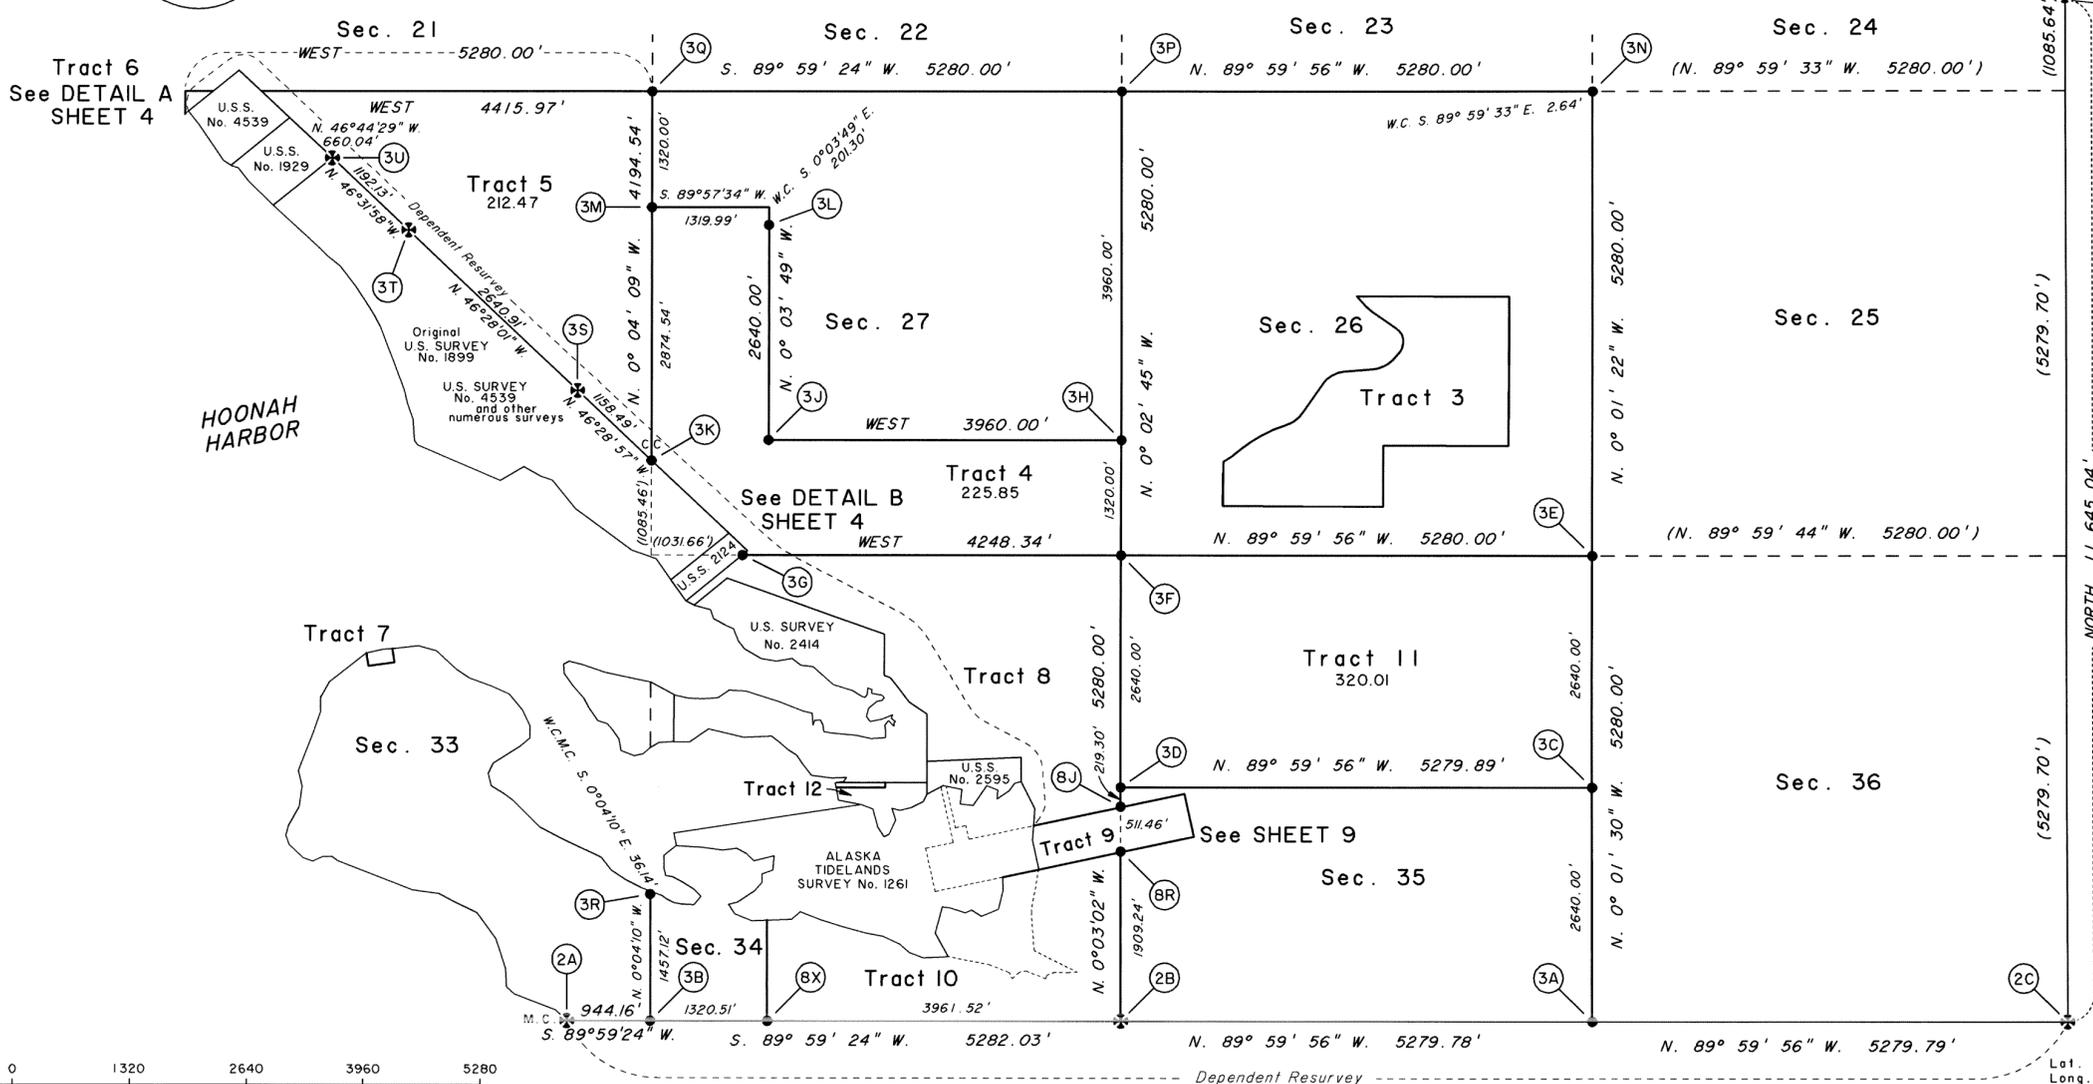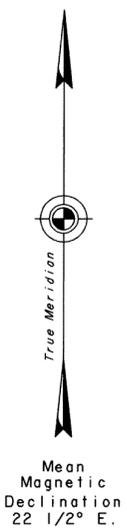

S. Hla 2006-29

Sheet 3 of 11 Sheets  
ALASKA NATIVE CLAIMS SETTLEMENT ACT  
(ANCSA) SECTION 14 (C) TRACTS 1 THROUGH 12  
P.L. 92-203, (85 STAT. 688, 702, 703)


HUNA TOTEM CORPORATION  
AT  
HOONAH, ALASKA  
AND

THE DEPENDENT RESURVEY OF THE SOUTH  
BOUNDARY AND THE RETRACEMENT OF THE EAST  
BOUNDARY OF T. 43 S., R. 61 E., C.R.M.,  
THE DEPENDENT RESURVEY OF PORTIONS OF  
U.S. SURVEY Nos. 1899, 1929, 2124, 2414,  
2595, 4539 AND THE RETRACEMENT OF ALASKA  
TIDELANDS SURVEY No. 1261.

REFERENCE SHOULD BE MADE TO  
SHEET No. 1 FOR SURVEY INFORMATION

NOTE

The letters "I" and "O" were not be used  
to identify monuments on this sheet.

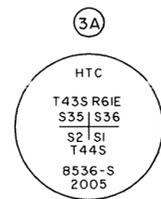

Set a stainless steel post, 28 ins. long, 2 1/2 ins. diam, 21 ins. in the ground, encircled by a rock collar, 18 ins. diam., with brass cap mkd. as shown, from which

A lodgepole pine, 6 ins. diam., bears N. 39 1/4° E., 153.4 ft. dist., mkd. X BT.


A lodgepole pine, 4 ins. diam., bears S. 57 1/4° E., 173.0 ft. dist., mkd. X BT.

A lodgepole pine, 5 ins. diam., bears S. 63 3/4° W., 195.9 ft. dist., mkd. X BT.

A lodgepole pine, 15 ins. diam., bears N. 16 1/4° W., 171.6 ft. dist., mkd. X BT.

Deposit a magnet in a white plastic case at the base of the stainless steel post.

Monument is located on gentle N slope, in a large muskeg. The "Town Road" bears W. 271 ft. dist., the road, 16 ft. wide, bears N. 4° E. and S. 4° W. The post is set in saturated organic soil.

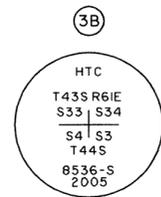

Set a stainless steel post, 28 ins. long, 2 1/2 ins. diam, 24 ins. in the ground, with brass cap mkd. as shown, from which

A hemlock, 5 ins. diam., bears N. 53 1/2° E., 26.0 ft. dist., mkd. X BT.


A magnet in a pink plastic case, bears S. 25 3/4° E., 12.9 ft. dist., buried 12 ins. below ground.

A hemlock, 4 ins. diam., bears S. 84 1/4° W., 40.2 ft. dist., mkd. X BT.

A hemlock, 9 ins. diam., bears N. 32° W., 61.4 ft. dist., mkd. X BT.

Deposit a magnet in a white plastic case at the base of the stainless steel post.

Monument is located at the N edge of clearcut, among hemlock and spruce, with berry bushes, false azalea and devil's club. The post is set in organic soil.

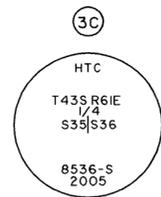


Set a stainless steel post, 28 ins. long, 2 1/2 ins. diam, 23 ins. in the ground, with brass cap mkd. as shown, from which

A lodgepole pine, 9 ins. diam., bears N. 52 1/4° E., 56.0 ft. dist., mkd. 1/4 S36 BT.

A hemlock, 6 ins. diam., bears N. 43 1/2° W., 42.5 ft. dist., mkd. 1/4 S35 BT.

Deposit a magnet in a white plastic case at the base of the stainless steel post.

Monument is located on gentle N slope, in a small oval-shaped muskeg, long axis in N-S direction, edges indeterminate; among scrub hemlock and lodgepole pine, with labrador tea, skunk cabbage and the various muskeg vegetation. The post is set in saturated organic soil.

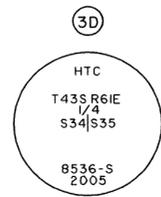


Set a stainless steel post, 28 ins. long, 2 1/2 ins. diam, 25 ins. in the ground, with brass cap mkd. as shown, from which

A spruce, 29 ins. diam., bears N. 47° E., 73.8 ft. dist., mkd. X BT.

A spruce, 10 ins. diam., bears N. 41° W., 83.4 ft. dist., mkd. X BT.

Deposit a magnet in a white plastic case at the base of the stainless steel post.

Monument is located on level ground, at the N clearing limits of the airport, among alder, with grasses. A slough, 22 ft. wide, bears S. 59 ft. dist., course N. 77° W. The post is set in saturated organic soil.

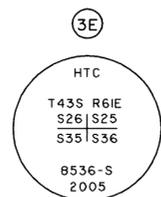

Set a stainless steel post, 28 ins. long, 2 1/2 ins. diam, 20 ins. in the ground, encircled by a rock collar, 12 ins. diam., with brass cap mkd. as shown, from which

A hemlock, 7 ins. diam., bears N. 65° E., 22.7 ft. dist., mkd. T43S R61E S25 BT.


A hemlock, 5 ins. diam., bears S. 55 1/4° E., 40.7 ft. dist., mkd. T43S R61E S36 BT.

A hemlock, 16 ins. diam., bears S. 40 3/4° W., 21.9 ft. dist., mkd. T43S R61E S35 BT.

A hemlock, 9 ins. diam., bears N. 35 1/4° W., 24.5 ft. dist., measured to a 60d nail, 6 ins. long, driven 3 ins. into NE side, mkd. T43S R61E S26 BT.

Deposit a magnet in a white plastic case at the base of the stainless steel post.

Monument is located on gentle W slope, among scrub hemlock, with wind-fallen trees and berry bushes and false azalea. The post is set in organic and mineral soils.

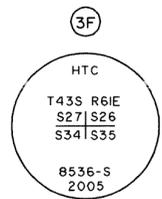

Set a stainless steel post, 28 ins. long, 2 1/2 ins. diam, 22 ins. in the ground, with brass cap mkd. as shown, from which

A spruce, 17 ins. diam., bears N. 25 1/4° E., 29.0 ft. dist., mkd. T43S R61E S26 BT.


A hemlock, 17 ins. diam., bears S. 65 1/2° E., 47.4 ft. dist., mkd. T43S R61E S35 BT.

A spruce, 26 ins. diam., bears S. 30 1/2° W., 57.8 ft. dist., mkd. T43S R61E S34 BT.

A hemlock, 19 ins. diam., bears N. 70 3/4° W., 22.6 ft. dist., mkd. T43S R61E S27 BT.

Deposit a magnet in a white plastic case at the base of the stainless steel post.

Monument is located on gentle W slope, among spruce and hemlock, with open under story. The post is set in organic soil over clay.

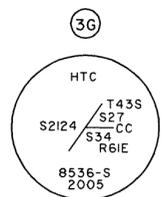


Set a stainless steel post, 28 ins. long, 2 1/2 ins. diam, 22 ins. in the ground, encircled by a rock collar, 12 ins. diam., with brass cap mkd. as shown, from which

A spruce, 12 ins. diam., bears S. 76 3/4° E., 21.8 ft. dist., mkd. X BT.

Deposit a magnet in a white plastic case at the base of the stainless steel post.

Monument is located on level ground, at the tree line, among spruce and hemlock, with berry bushes, devil's club, ferns and grasses. A chain link fence, 8 ft. high, bears NW, 0.9 ft. dist., fence bears N. 51° E. and S. 51° W. The post is set in black organic soil over clay.

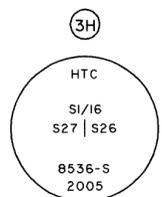


Set a stainless steel post, 28 ins. long, 2 1/2 ins. diam, 22 ins. in the ground, encircled by a rock collar, 14 ins. diam., with brass cap mkd. as shown, from which

A hemlock, 8 ins. diam., bears S. 55° E., 38.2 ft. dist., mkd. SI/16 S26 BT.

A hemlock, 12 ins. diam., bears S. 50 3/4° W., 49.9 ft. dist., mkd. SI/16 S27 BT.

Deposit a magnet in a white plastic case at the base of the stainless steel post.

Monument is located on steep S slope, among hemlock and spruce, with no under story. The post is set in organic soil over clay.

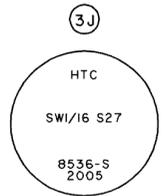


Set a stainless steel post, 28 ins. long, 2 1/2 ins. diam, 22 ins. in the ground, encircled by a rock collar, 12 ins. diam., with brass cap mkd. as shown, from which

A hemlock, 10 ins. diam., bears N. 69° E., 24.0 ft. dist., measured to a 60d nail, 6 ins. long, driven 3 ins. into S side, mkd. X BT.

A hemlock, 14 ins. diam., bears N. 45° W., 22.8 ft. dist., mkd. X BT.

Deposit a magnet in a white plastic case at the base of the stainless steel post.

Monument is located on small bench between two draws, among hemlock, with dense second growth, berry bushes, false azalea, and devil's club. A creek, 15 ft. wide, bears N. 112 ft. dist., course S. 48° W. The post is set in organic and mineral soils.

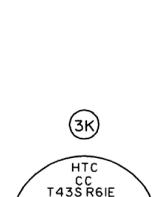


Set a stainless steel post, 28 ins. long, 2 1/2 ins. diam, 22 ins. in the ground, encircled by a rock collar, 12 ins. diam., with brass cap mkd. as shown, from which

A spruce, 30 ins. diam., bears S. 63 1/4° W., 39.9 ft. dist., mkd. X BT.

A hemlock, 10 ins. diam., bears N. 41 3/4° W., 38.9 ft. dist., mkd. X BT.

Deposit a magnet in a white plastic case at the base of the stainless steel post.

Monument is located on nearly level ground, with dense berry bushes in green belt between blocks of single family frame homes. The post is set in organic and mineral soil over clay.

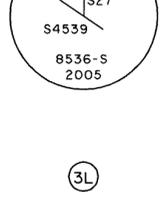


Set a stainless steel post, 28 ins. long, 2 1/2 ins. diam, 20 ins. in the ground, encircled by a rock collar, 12 ins. diam., with brass cap mkd. as shown, from which

A hemlock, 17 ins. diam., bears S. 66 3/4° E., 8.3 ft. dist., mkd. X BT.

A spruce, 6 ins. diam., bears S. 29 1/2° W., 22.5 ft. dist., mkd. X BT.

Deposit a magnet in a white plastic case at the base of the stainless steel post.

True point falls in ravine, therefore monument is located at top of N slope, among hemlock, with dense berry bushes, false azalea, and mosses. The top of a cliff, bears N. 12 ft. dist., top bears N. 86° W. and S. 82° E. The post is set in organic and mineral soils.

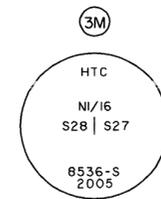


Set a stainless steel post, 28 ins. long, 2 1/2 ins. diam, 23 ins. in the ground, encircled by a rock collar, 10 ins. diam., with brass cap mkd. as shown, from which

A hemlock, 11 ins. diam., bears S. 88 1/4° E., 19.5 ft. dist., measured to a 60d spike, 6 ins. long, driven 3 ins. into N side, mkd. X BT.

A hemlock, 10 ins. diam., bears S. 30 1/2° W., 13.3 ft. dist., mkd. NI/16 S28 BT.

Deposit a magnet in a white plastic case at the base of the stainless steel post.

Monument is located on steep S slope, in very dense second growth and wind-fallen trees. The post is set in organic and mineral soils.

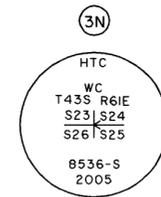

Set a stainless steel post, 28 ins. long, 2 1/2 ins. diam, 24 ins. in the ground, with brass cap mkd. as shown, from which

A hemlock, 3 ins. diam., bears N. 23 3/4° E., 18.2 ft. dist., measured to a 60d nail, 6 ins. long, driven 3 ins. into S side, mkd. X BT.


A hemlock, 13 ins. diam., bears S. 84 1/4° E., 42.5 ft. dist., mkd. X BT.

A hemlock, 7 ins. diam., bears S. 5 3/4° W., 27.2 ft. dist., measured to a 60d nail, 6 ins. long, driven 3 ins. into W side, mkd. X BT.

A hemlock, 6 ins. diam., bears N. 85° W., 8.4 ft. dist., measured to a 60d nail, 6 ins. long, driven 3 ins. into N side, mkd. X BT.

Deposit a magnet in a white plastic case at the base of the stainless steel post.

True point falls in a slump, therefore monument is located on a small knob at the N edge of clearcut, edge bears N. 85° E. and S. 70° E., among hemlock, with berry bushes, false azalea, and devil's club. The post is set in organic and mineral soils.

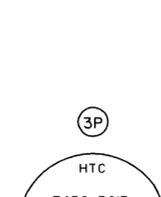

Set a stainless steel post, 28 ins. long, 2 1/2 ins. diam, 24 ins. in the ground, encircled by a rock collar, 12 ins. diam., with brass cap mkd. as shown, from which

A hemlock, 12 ins. diam., bears N. 52 1/2° E., 35.3 ft. dist., mkd. T43S R61E S23 BT.

A spruce, 20 ins. diam., bears S. 59 1/4° E., 65.2 ft. dist., mkd. T43S R61E S26 BT.

A hemlock, 12 ins. diam., bears S. 61° W., 41.4 ft. dist., mkd. T43S R61E S27 BT.

A hemlock, 11 ins. diam., bears N. 46° W., 11.2 ft. dist., mkd. T43S R61E S22 BT.

Deposit a magnet in a white plastic case at the base of the stainless steel post.



Set a stainless steel post, 28 ins. long, 2 1/2 ins. diam, 22 ins. in the ground, encircled by a rock collar, 8 ins. diam., with brass cap mkd. as shown, from which


A spruce, 11 ins. diam., bears N. 54 1/2° E., 20.1 ft. dist., mkd. T43S R61E S22 BT.

A hemlock, 8 ins. diam., bears S. 66 1/2° E., 11.1 ft. dist., mkd. T43S R61E S27 BT.

A spruce, 13 ins. diam., bears S. 70 1/2° W., 23.7 ft. dist., mkd. T43S R61E S28 BT.

A hemlock, 13 ins. diam., bears N. 41° W., 79.0 ft. dist., mkd. T43S R61E S21 BT.

Deposit a magnet in a white plastic case at the base of the stainless steel post.

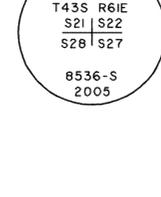


Monument is located on shoulder of small bench with gentle W slope, hemlock and occasional spruce, with berry bushes, false azalea, and plantain. The post is set in organic soil over clay.

Set a stainless steel post, 28 ins. long, 2 1/2 ins. diam, 22 ins. in the ground, encircled by a rock collar, 8 ins. diam., with brass cap mkd. as shown, from which

A spruce, 4 ins. diam., bears S. 0 1/2° W., 35.3 ft. dist., mkd. X BT.

A spruce, 7 ins. diam., bears S. 81 1/4° W., 35.8 ft. dist., mkd. X BT.

Deposit a magnet in a white plastic case at the base of the stainless steel post.

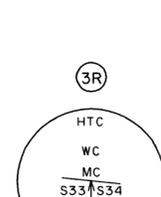

True point for the meander corner of secs. 33 and 34 bears N. 0°04'10" W., 36.14 ft. dist., falls on cobble beach, at the line of mean high tide, not monumented due to the liability of destruction by tidal action.

Monument is located on S side of small bight in Gartina Creek estuary. The post is set in cobbles and clay.

Found an iron post, 2 ins. diam., firmly set, projecting 5 ins. above ground, encircled by a rock collar, 12 ins. diam., with a brass cap mkd. as shown, from which the original bearing trees

A rotted stump, 10 ins. diam., bears N. 51 1/2° E., 79.7 ft. dist., with no mks. visible.

A hemlock, 16 ins. diam., bears S. 11 3/4° E., 30.7 ft. dist., with a completely healed blaze.

and new bearing tree

A spruce, 21 ins. diam., bears S. 85° W., 24.7 dist., mkd. X BT.

Add the mks. 2005 to the brass cap.

Found an iron post, 2 ins. diam., firmly set, projecting 12 ins. above ground, encircled by a rock collar, 14 ins. diam., with the mks. 3 HE peened into the side of the post, from which the original bearing trees

A hemlock, 22 ins. diam., bears N. 36 1/4° E., 5.3 ft. dist., with scribe mks. 1/2MI SI899 BT visible in a partially healed blaze. (Record: N. 50° E.)

A rotted stump, 16 ins. diam., bears S. 5° E., 16.1 ft. dist., with scribe mks. H6 1/2MI SI899 BT. (Record: South)

and new bearing tree

A hemlock, 11 ins. diam., bears S. 1° W., 24.6 dist., mkd. X BT.

Found an iron post, 2 ins. diam., firmly set, projecting 8 ins. above ground, encircled by a rock collar, 16 ins. diam., with a brass cap mkd. as shown, from which the remaining bearing tree

A hemlock, 29 ins. diam., bears N. 50 3/4° W., 19.4 ft. dist., with illegible scribe mks. visible in a partially healed blaze.

and new bearing tree

A spruce, 34 ins. diam., bears N. 12 1/4° E., 43.5 dist., mkd. X BT.

Add the mks. 2005 to the brass cap.

Sheet 4 of 11 Sheets  
ALASKA NATIVE CLAIMS SETTLEMENT ACT  
(ANCSA) SECTION 14 (C) TRACTS 1 THROUGH 12  
P.L. 92-203, (85 STAT. 688, 702, 703)


HUNA TOTEM CORPORATION  
AT  
HOONAH, ALASKA  
AND

THE DEPENDENT RESURVEY OF THE SOUTH  
BOUNDARY AND THE RETRACEMENT OF THE EAST  
BOUNDARY OF T. 43 S., R. 61 E., C.R.M.,  
THE DEPENDENT RESURVEY OF PORTIONS OF  
U.S. SURVEY Nos. 1899, 1929, 2124, 2414,  
2595, 4539 AND THE RETRACEMENT OF ALASKA  
TIDELANDS SURVEY No. 1261.

REFERENCE SHOULD BE MADE TO  
SHEET No. 1 FOR SURVEY INFORMATION



NOTE  
Monument identifiers represent the sheet on  
which the monument description is located.

NOTE  
The line between the meander cor. of secs. 28 and 29  
and cor. No. 2, U.S. Survey No. 4539, a meander cor.  
represents the historical line of mean high tide prior to  
the filling of tidelands for the construction of the road  
fronting U.S. Survey No. 4539. This line was determined  
from historical photographs of the area locally known  
as the "Tunnel", which clearly identifies the line of mean  
high tide along a well defined rock face in existence  
prior to the construction.

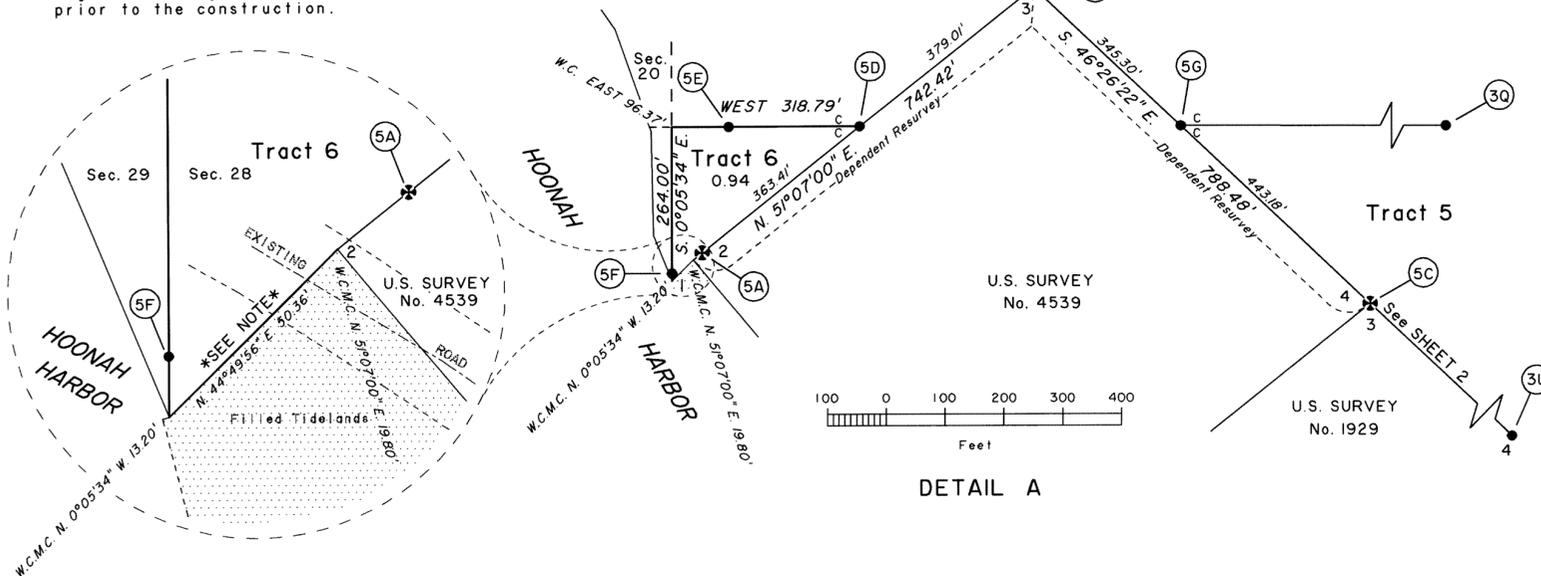

MEANDER TRACT 6


From the true point for the most southerly corner of  
Tract 6, a meander corner, not monumented.  
Thence with the meander of Hoonah Harbor, along a steeply  
sloping beach of boulders, across the constructed roadway,  
1. N. 44°49'56" E., 50.36 ft. At end of course, the true  
point for record position of  
corner No. 2, U.S. Survey  
No. 1899, a meander corner,  
not monumented.

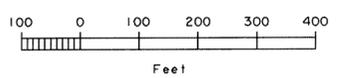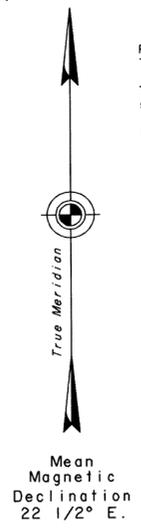


DETAIL A

LEGEND

- Found BLM/GLO Monument
- Set Monument This Survey
- Set 5/8" Diam. Rebar With Alum. Cap This Survey
- Found Primary Monument by Others

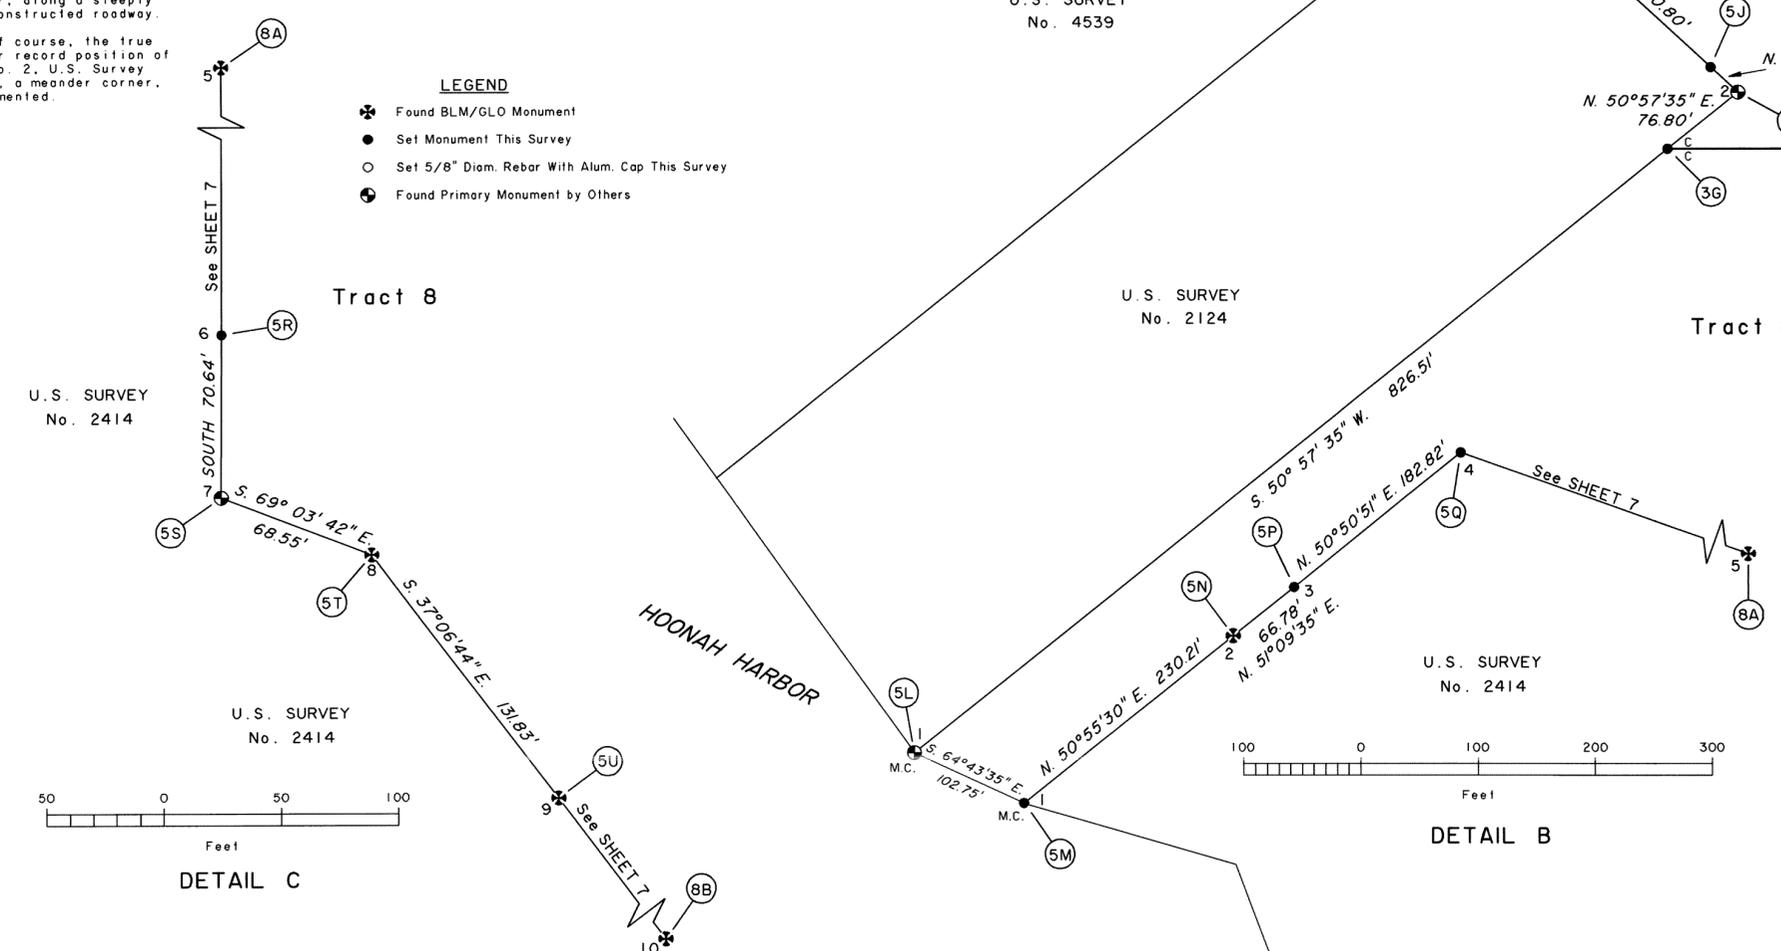

DETAIL C

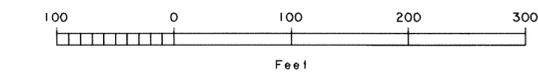

DETAIL B

ALASKA NATIVE CLAIMS SETTLEMENT ACT (ANCSA) SECTION 14 (C) TRACTS I THROUGH 12 P.L. 92-203, (85 STAT. 688, 702, 703)

HUNA TOTEM CORPORATION AT HOONAH, ALASKA AND

THE DEPENDENT RESURVEY OF THE SOUTH BOUNDARY AND THE RETRACEMENT OF THE EAST BOUNDARY OF T. 43 S., R. 61 E., C.R.M., THE DEPENDENT RESURVEY OF PORTIONS OF U.S. SURVEY Nos. 1899, 1929, 2124, 2414, 2595, 4539 AND THE RETRACEMENT OF ALASKA TIDELANDS SURVEY No. 1261.

REFERENCE SHOULD BE MADE TO SHEET No. 1 FOR SURVEY INFORMATION

NOTE

The letters "I" and "O" were not be used to identify monuments on this sheet.

Re-establish cor. at single proportionate position. There is no remaining evidence of the original cor. position.

At the cor. point,

Set a stainless steel post, 28 ins. long, 2 1/2 ins. diam., 22 ins. in the ground, with a brass cap mkd. as shown, from which the following improvement

The most S cor. of house, 43 ft. x 41 ft., bears N. 31° W., 70.8 ft. dist., long side bears N. 72° W.

Deposit a magnet in a white plastic case at the base of the stainless steel post.

Monument is located in a garden. The post is set in organic soil.

From this point, the original iron post, 1 in. diam., firmly set, projecting 1 in. above ground, with brass cap mkd. S2414 C6 LOT11 C4 1938 bears S. 15 1/4° W., 4.11 ft. dist. This monument location is suspect relative to other corners of this survey and previous surveys. Mr. Ken Deitering, resident and landowner adjacent to cor., furnished a signed statement, recorded as Serial No. 2006-001028-0, Sitka Recording District, attesting to the disturbance of the original cor. Remove original cap markings and mark cap to now read AM 4.11 FT TO COR 2005 1938 and an arrow pointing to the re-established cor.

Found cor. perpetuated in 1991 by James A. Wilson, Alaska Registered Land Surveyor No. 4725-S, with an alum. post, 2 ins. diam., firmly set, flush with the ground, with alum. cap mkd. as shown.

No accessories remain.

This cor. is accepted as a careful and faithful perpetuation of the original cor.

No remaining evidence of the original cor. due to the construction of Garlina Highway.

No accessories remaining.

At the cor. point, re-established by Grant Boundary adjustment, using cor. Nos. 5 & 9, U.S. Survey No. 2414

Drive an iron rebar, 3/8 in. diam., 36 ins. in the ground, encircled by a rock collar, 12 ins. diam., with alum. cap mkd. as shown.

Monument is located 23.1 ft. South of the centerline of Garlina Highway, 28.3 ft. wide, bears N. 66° W. and S. 66° E., on fill slope of SW side of said highway.

Found an iron post, 1 in. diam., firmly set, projecting 4 ins. above ground, with a brass cap mkd. as shown, from which the only remaining bearing tree

A hemlock stump, 13 ins. diam., bears N. 58° W., 43.8 ft. dist., with no scribe mks. visible in the rotted portion of the partially healed blaze.

and new bearing trees

A spruce, 6 ins. diam., bears S. 9° E., 3.8 ft. dist., mkd. X BT.

A hemlock, 7 ins. diam., bears N. 86 1/2° W., 28.2 ft. dist., mkd. X BT.

Add the mks. 2005 to the brass cap.

5A Found an iron post, 2 ins. diam., firmly set, 18 ins. below the ground surface, with a brass cap mkd. as shown, from which no original bearing objects survived the weathered and fractured rock and new bearing objects

A brass tablet, 2 ins. diam., bears S. 70 1/2° W., 64.0 ft. dist., set horizontal on small ledge at the end of guard rail, mkd. RM2 WCMC-21 TRA ATSI569 LS5713 1999.

A brass tablet, 2 ins. diam., bears S. 89 1/4° W., 4.7 ft. dist., set vertical in cliff 7.7 ft. above ground, mkd. ALS ATSI569 MC-21 AZ MK LS5713 1999.

Add the mks. 2005 to the brass cap.

5B Found an iron post, 2 ins. diam., firmly set, projecting 6 ins. above ground, with a brass cap mkd. as shown, from which the original bearing trees

A hemlock, 14 ins. diam., bears South, 15.0 ft. dist., with a completely healed blaze.

A hemlock snag, 29 ins. diam., bears N. 53 1/2° W., 47.2 ft. dist., with scribe mks. visible in a partially healed and rotting blaze. (Record: N. 50 1/2° W., 70 lks.)

and a new bearing tree

A spruce, 28 ins. diam., bears N. 72 1/2° E., 17.6 ft. dist., mkd. X BT.

Add the mks. 2005 to the brass cap.

5C Found an iron post, 2 ins. diam., loosely set, projecting 18 ins. above ground, with a brass cap mkd. as shown, from which the only remaining bearing tree

A hemlock snag, 12 ins. diam., bears S. 6 1/2° E., 13.3 ft. dist., with scribe mks. visible in a partially healed and rotting blaze. (Record: S. 24 3/4° E.)

At the cor. point, reset the original post, 36 ins. long, 24 ins. in the ground,

from which new bearing trees

A hemlock, 17 ins. diam., bears N. 46 1/2° E., 29.9 ft. dist., mkd. X BT.

A hemlock, 14 ins. diam., bears N. 50 1/2° W., 24.3 ft. dist., mkd. X BT.

Deposit a magnet in a white plastic case at the base of the iron post.

Add the mks. 2005 to the brass cap.

5D Set a stainless steel post, 28 ins. long, 2 1/2 ins. diam, 10 ins. in the ground, supported by a rock mound, 30 ins. at base, 13 ins. high, with brass cap mkd. as shown, from which

A spruce, 6 ins. diam., bears S. 60 1/2° W., 59.3 ft. dist., mkd. X BT.

A hemlock, 7 ins. diam., bears N. 10 1/4° W., 21.6 ft. dist., meas. to a 60d spike, 6 ins. long, driven 3 ins. into S side, mkd. X BT.

Deposit a magnet in a white plastic case at the base of the stainless steel post.

Monument is located on N shoulder of bench, in a shallow pit above a steep N slope, among hemlock and occasional spruce, with open under story. The post is set in organic soil over broken limestone.

5E Set a stainless steel post, 28 ins. long, 2 1/2 ins. diam, 18 ins. in the ground, supported by a rock mound, 23 ins. at base, 12 ins. high, with brass cap mkd. as shown, from which

A hemlock, 15 ins. diam., bears N. 18 1/4° E., 23.3 ft. dist., mkd. X BT.

A hemlock, 22 ins. diam., bears S. 75 3/4° E., 13.7 ft. dist., mkd. X BT.

A hemlock, 9 ins. diam., bears S. 35 1/2° W., 24.7 ft. dist., mkd. X BT.

A spruce, 11 ins. diam., bears N. 72 1/2° W., 14.1 ft. dist., mkd. X BT.

Deposit a magnet in a white plastic case at the base of the stainless steel post.

True point bears W., 96.37 ft. dist., on face of a rock cliff, where it is impractical to establish a permanent monument. Monument is located on steep NW slope, among hemlock and spruce, with berry bushes, false azalea, and devil's club. A trail bears W., 24 ft. dist., trail bears N. 10° E. and S. 14° W. Top of cliff, 200 ft. high, bears W., 69 ft. dist., top bears N. and S. 65° W. The post is set in organic soil over broken limestone and bedrock.

5F Set a stainless steel post, 28 ins. long, 2 1/2 ins. diam, 20 ins. in the ground, encircled by a rock collar, 16 ins. diam., with brass cap mkd. as shown, from which

A brass tablet, 2 ins. diam., bears N. 53 3/4° E., 57.3 ft. dist., set vertical in cliff, 7.7 ft. above ground, mkd. ALS ATSI569 MC-21 AZ MK LS5713 1999.

A brass tablet, 2 ins. diam., bears N. 34 1/2° W., 16.6 ft. dist., set horizontal on small ledge at the end of guard rail, mkd. RM2 WCMC-21 TRA ATSI569 LS5713 1999.

Deposit a magnet in a white plastic case alongside of the stainless steel post.

Monument is located on level ground, at the base of rock cut at the "Tunnel" (local name), on SW side of road. The post is set in mineral soil with rock and gravel.

5G Set a stainless steel post, 28 ins. long, 2 1/2 ins. diam, 26 ins. in the ground, encircled by a rock collar, 12 ins. diam., with brass cap mkd. as shown, from which

A hemlock, 12 ins. diam., bears N. 51 1/4° E., 15.2 ft. dist., mkd. X BT.

A hemlock, 10 ins. diam., bears S. 65 1/4° E., 43.8 ft. dist., mkd. X BT.

Deposit a magnet in a white plastic case at the base of the stainless steel post.

Monument is located on NW edge of waterline corridor on a gentle W slope, among hemlock, with devil's club and berry bushes. The post is set in saturated organic and mineral soils.

5H Found cor. perpetuated in 1987 by Robert Hungerford, Alaska Registered Land Surveyor No. 5453-S, with an alum. post, 2 1/2 ins. diam., firmly set, projecting 7 ins. above the ground, with alum. cap mkd. as shown, from which the only remaining 1932 bearing tree

A hemlock, 13 ins. diam., bears S. 16 1/2° W., 22.5 ft. dist., with a completely healed blaze.

This cor. is accepted as a careful and faithful perpetuation of the original cor.

from which a new bearing tree

A hemlock, 9 ins. diam., bears N. 83 3/4° E., 28.6 ft. dist., meas. to a 60d spike, 6 ins. long, driven 3 ins. into S side, mkd. X BT.

Add the mks. 2005 to the alum. cap.

5J Found a rusted and bent iron post, 2 ins. diam., firmly set and leaning, projecting 12 ins. above the ground, with the mks. 4 HE peened into the side of the post, from which the only remaining 1930 bearing tree

A spruce snag, 16 ins. diam., bears N. 58° E., 14.5 ft. dist., with the mks. E 1/2 MI 899 BT visible in a partially healed blaze.

At the cor. point,

Set a stainless steel post, 28 ins. long, 2 1/2 ins. diam, 25 ins. in the ground, encircled by a rock collar, 14 ins. diam., with brass cap mkd. as shown, from which

A spruce, 8 ins. diam., bears N. 11 1/2° E., 27.6 ft. dist., mkd. X BT.

A hemlock, 9 ins. diam., bears S. 71 1/4° E., 30.3 ft. dist., mkd. X BT.

Deposit a magnet in a white plastic case at the base of the stainless steel post.

Reset the iron post alongside the stainless steel post as a guard stake.

Monument is located on level ground near a chain link fence, among hemlock and spruce, with berry bushes, false azalea, ferns, skunk cabbage and devil's club. The post is set in organic soil over clay.

5K Found an iron post, 1 in. diam., firmly set, projecting 12 ins. above ground, with a brass cap mkd. as shown, from which the original bearing trees

A rotted stump, 13 ins. diam., bears S. 15 1/4° W., 15.9 ft. dist., with scribe mks. visible in a partially healed blaze.

A hemlock, 17 ins. diam., bears N. 60 1/2° W., 13.8 ft. dist., with scribe mks. visible in a partially healed blaze.

and new bearing tree

A hemlock, 11 ins. diam., bears N. 21 1/2° E., 13.2 ft. dist., mkd. X BT.

Add the mks. 2005 to the brass cap.

5L Found cor. perpetuated in 1999 by Thomas M. Kirchner, Alaska Registered Land Surveyor No. 5713, with an alum. tablet, 3 1/4 ins. diam., mkd. as shown, cemented into the original outcrop of bedrock, plainly mkd. IHE MC on the S and SE faces, from which the only remaining 1932 bearing tree

A spruce, 30 ins. diam., bears N. 72 1/4° E., 61.3 ft. dist., with a completely healed blaze.

And the 1999 accessories.

A brass tablet, 2 ins. diam., bears N. 27° E., 5.0 ft. dist., mkd. RM3 MCI TRB ATSI569 LS5713 1999.

A spruce, 31 ins. diam., bears S. 78 1/2° E., 39.4 ft. dist., with private bearing tree tag which reads N77W 39.0 USS2124/1899 C2 ALS 8/19/99.

A brass tablet, 2 ins. diam., bears S. 52° W., 10.0 ft. dist., mkd. RMI MCI TRB ATSI569 LS5713 1999.

An alum. tablet, 3 1/4 ins. diam., bears S. 52° W., 20.0 ft. dist., mkd. ATSI569 RMI ATSI29 MCI TRB LS5713 1999.

This cor. is accepted as a careful and faithful perpetuation of the original cor.

5M Found cor. perpetuated in 1983 by Malcolm A. Menzies with a bent alum. rod, 3/4 ins. diam., with an unmarked, 3 1/4 ins. diam. alum. cap, with manufactured inscription "R&M CONSULTANTS 1410-S", loosely set in a crack of a weathered bedrock outcrop from which the remaining original bearing trees

A spruce, 25 ins. diam., bears N. 3° W., 45.7 ft. dist., with no scribe mks. visible in a partially healed blaze.

A rotted stump, 12 ins. diam., flush with the ground, bears N. 62 1/2° E., 28.0 ft. dist., with no scribe mks. visible.

This cor. is accepted as a careful and faithful perpetuation of the original cor.

At the cor. point,

Remove and destroy Menzies monument. No remaining evidence of the original 1938 tablet, drill hole, or cement was found. The top layer of the weathered outcrop was removed to provide solid purchase for new monument. Epoxy a brass tablet, 3 1/4 ins. diam., 3 ins. long stem, mkd. as shown, in a drill hole, 8 ins. deep, in a bedrock outcrop, 2.0 ft. x 2.5 ft. exposed, from which a new bearing tree

A spruce, 21 ins. diam., bears S. 83 1/4° E., 27.0 ft. dist., mkd. X BT.

Deposit a magnet in the drill hole at the base of the brass tablet.

5N Found an iron post, 2 ins. diam., firmly set, projecting 2 ins. above ground, with a brass cap mkd. as shown, from which the only remaining original bearing tree

A hemlock, 26 ins. diam., bears N. 53 3/4° W., 22.7 ft. dist., with a completely healed blaze.

and new bearing tree

A hemlock, 11 ins. diam., bears S. 45° W., 30.1 ft. dist., mkd. X BT.

Add the mks. 2005 to the brass cap.

5P No evidence of the original monument due to fill for the construction of Eagle Dr.; position determined at record bearing and distance from the remaining original bearing tree

A hemlock, 12 ins. diam., bears S. 72 1/4° E., 62.0 ft. dist., with a completely healed blaze.

At the cor. point,

Set a stainless steel post, 28 ins. long, 2 1/2 ins. diam, 24 ins. in the ground, with a brass cap mkd. as shown, from which the new accessories

A power pole on Garlina Highway, 13 ins. diam., bears N. 80 3/4° E., 28.0 ft. dist., mkd. with Serial No. 2110-2111.

A hemlock, 14 ins. diam., bears S. 22 1/2° W., 45.6 ft. dist., meas. to a 16d nail, 3 ins. long, driven 1 1/2 ins. into N side, mkd. X BT.

Deposit a magnet in a white plastic case at the base of the stainless steel post.

Monument is located on the SE edge of closed portion of Eagle Dr., a gravel road, 20 ft. wide, edge bears N. 50° E. and S. 50° W. The centerline of Garlina Highway, bears S. 39 ft. dist., centerline bears N. 52° W. and S. 52° E. The post is set in road construction rock with no soil.

From this point, an iron rebar, 5/8 in. diam., firmly set, flush with ground, with a yellow plastic cap inscribed JOHNSON S-7570, bears S. 36°10'26" E., 65.92 ft. dist., and was not used during the course of this survey.

5Q No evidence of the original monument due to fill for the construction of Eagle Dr.; position determined at record distances from the remains of the original bearing trees

A hemlock snag, 12 ins. diam., bears S. 22° E., 29.4 ft. dist., with scribe mks. visible in a partially healed blaze.

A rotted stump, 12 ins. diam., bears S. 33° W., 48.9. ft. dist., with no scribe mks. visible.

At the cor. point,

Set a stainless steel post, 28 ins. long, 2 1/2 ins. diam., flush with the ground, with a brass cap mkd. as shown, from which the new accessories

The second power pole northerly from Garlina Highway, 10 ins. diam., bears N. 51 1/4° E., 62.8 ft. dist., no marks.

A hemlock, 17 ins. diam., bears S. 53° E., 22.6 ft. dist., mkd. X BT.

Deposit a magnet in a white plastic case at the base of the stainless steel post.

Monument is located on the SE edge of closed portion of Eagle Dr., a gravel road, 20 ft. wide, edge bears N. 50° E. and S. 50° W. A creek, 2 ft. wide, bears S., 9 ft. dist., course N. 70° W. The post is set in road construction rock with no soil.

From this point, an iron rebar, 5/8 in. diam., firmly set, flush with ground, with a yellow plastic cap inscribed JOHNSON S-7570, bears S. 29° 59' W., 13 ft. dist., and was not used during the course of this survey.

Sheet 6 of 11 Sheets  
**ALASKA NATIVE CLAIMS SETTLEMENT ACT**  
**(ANCSA) SECTION 14 (C) TRACTS 1 THROUGH 12**  
**P.L. 92-203, (85 STAT. 688, 702, 703)**

**HUNA TOTEM CORPORATION**  
**AT**  
**HOONAH, ALASKA**  
**AND**  
**THE DEPENDENT RESURVEY OF THE SOUTH**  
**BOUNDARY AND THE RETRACEMENT OF THE EAST**  
**BOUNDARY OF T. 43 S., R. 61 E., C.R.M.,**  
**THE DEPENDENT RESURVEY OF PORTIONS OF**  
**U.S. SURVEY Nos. 1899, 1929, 2124, 2414,**  
**2595, 4539 AND THE RETRACEMENT OF ALASKA**  
**TIDELANDS SURVEY No. 1261.**



REFERENCE SHOULD BE MADE TO  
 SHEET No. 1 FOR SURVEY INFORMATION

**NOTE**


The letter "I" was not be used to  
 identify any monuments on this sheet.

**ROAD CURVE TABLE**

DELTA	RADIUS	CHORD BRG	CHORD	LENGTH
1. 10° 17' 03"	1361.65'	N. 54° 12' 52" E.	244.09'	244.41'
2. 23° 51' 12"	1360.13'	N. 60° 59' 58" E.	562.15'	566.25'
3. 37° 56' 55"	366.50'	N. 53° 57' 03" E.	238.33'	242.74'
4. 49° 50' 00"	298.11'	N. 59° 53' 42" E.	251.20'	259.28'
5. 47° 19' 33"	390.37'	N. 61° 09' 03" E.	313.35'	322.44'
6. 92° 22' 15"	187.23'	N. 8° 41' 50" W.	270.20'	301.85'
7. 11° 41' 00"	528.21'	N. 49° 02' 32" W.	107.52'	107.71'

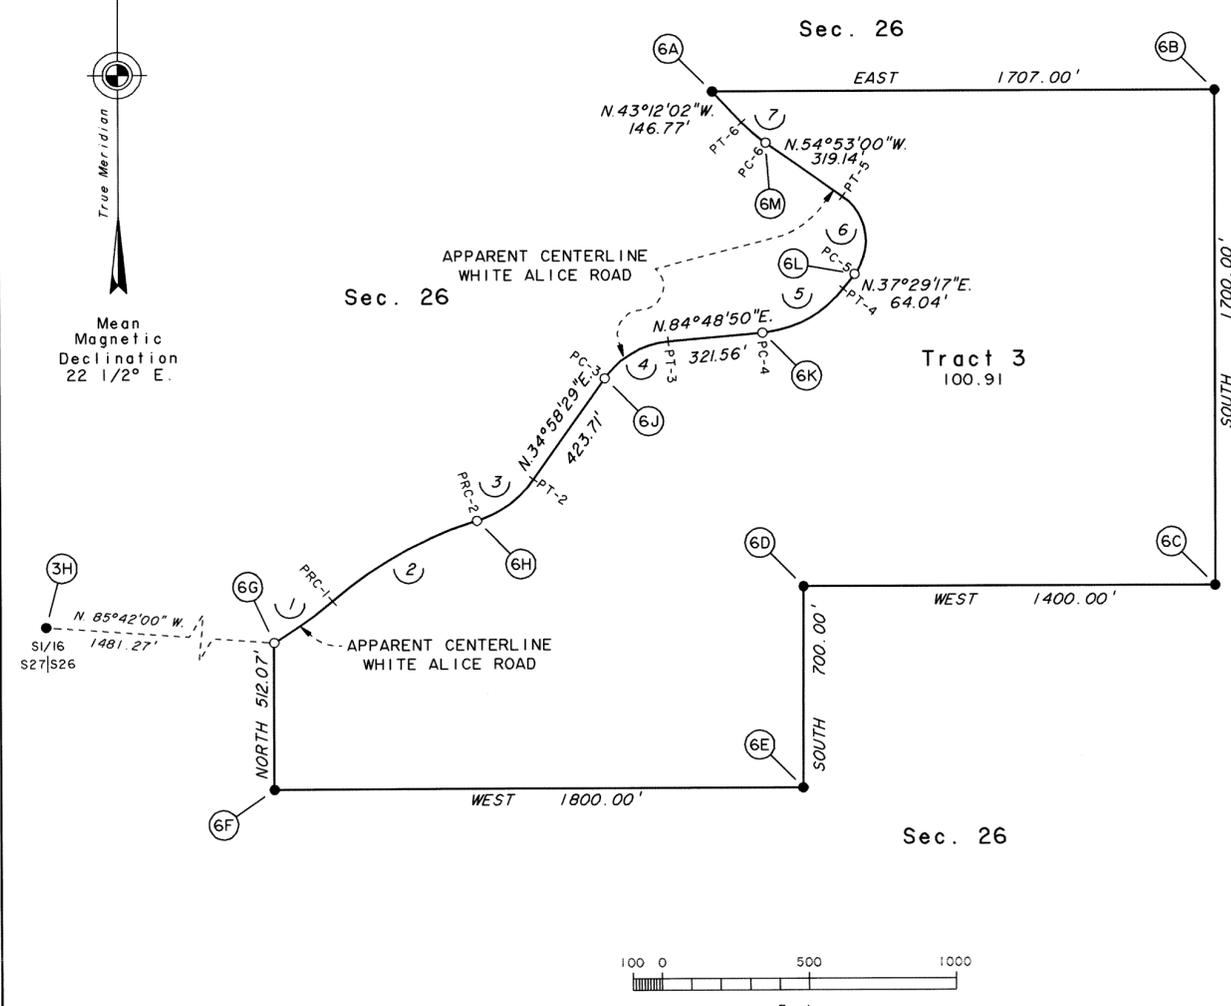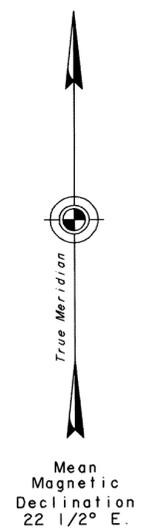

- LEGEND**
- ⊗ Found BLM/GLO Monument
  - Set Monument This Survey
  - Set 5/8" Diam. Rebar With Alum. Cap This Survey
  - ⊙ Found Primary Monument by Others

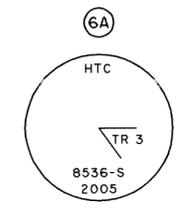


Epoxy a brass tablet, 3 1/2 ins. long stem, 3 1/2 ins. diam., in a drill hole, 7 ins. deep into bedrock, 2 ins. below the road surface, with cap mkd. as shown, from which

A magnet, epoxied into a drill hole, 4 ins. into vertical rock cliff, bears N. 83° E., 28.8 ft. dist., capped with silver plastic case.

A magnet, epoxied into a drill hole, 4 ins. into vertical rock cliff, bears N. 24° W., 50.0 ft. dist., capped with an orange plastic case.

Deposit a magnet in the drill hole at the base of brass tablet.

Monument is located in the roadway of the White Alice Road. The most E gate post, 6 1/2 ins. diam., firmly set, leaning SE, bears E. 7 ft. dist.

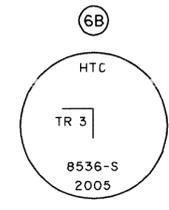


Set a stainless steel post, 28 ins. long, 2 1/2 ins. diam., 22 ins. in the ground, encircled by a rock collar, 14 ins. diam., with brass cap mkd. as shown, from which

A hemlock, 11 ins. diam., bears S. 46 3/4° E., 17.2 ft. dist., meas. to a 60d nail, 6 ins. long, driven 3 ins. into W side, mkd. X BT.

A hemlock, 31 ins. diam., bears S. 15 3/4° W., 13.4 ft. dist., mkd. X BT.

Deposit a magnet in a white plastic case at the base of the stainless steel post.

Monument is located on steep NE slope, among hemlock and wind-fallen trees, with dense berry bushes, false azalea, and devil's club. The post is set in organic and mineral soils with clay.

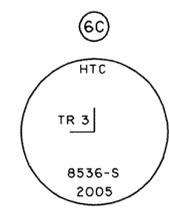


Set a stainless steel post, 28 ins. long, 2 1/2 ins. diam., 25 ins. in the ground, encircled by a rock collar, 10 ins. diam., with brass cap mkd. as shown, from which

A hemlock, 7 ins. diam., bears N. 17 3/4° E., 24.2 ft. dist., mkd. X BT.

A hemlock, 5 ins. diam., bears S. 75 3/4° E., 12.6 ft. dist., mkd. X BT.

Deposit a magnet in a white plastic case at the base of the stainless steel post.

Monument is located on level ground, in a clear cut, among second growth of hemlock, with berry bushes and false azalea. The post is set in organic soil over clay.

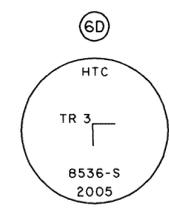


Set a stainless steel post, 28 ins. long, 2 1/2 ins. diam., 24 ins. in the ground, with brass cap mkd. as shown, from which

A hemlock, 7 ins. diam., bears N. 15° E., 29.1 ft. dist., meas. to a 60d nail, 6 ins. long, driven 3 ins. into W side, mkd. X BT.

A hemlock, 12 ins. diam., bears S. 87 1/4° E., 32.8 ft. dist., mkd. X BT.

Deposit a magnet in a white plastic case at the base of the stainless steel post.

Monument is located on S flank of ridge, among stunted hemlock, with dense berry bushes and false azalea. Ridge bears E and W. The post is set in organic and mineral soil.

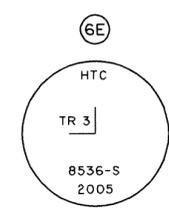


Set a stainless steel post, 28 ins. long, 2 1/2 ins. diam., 24 ins. in the ground, encircled by a rock collar, 15 ins. diam., with brass cap mkd. as shown, from which

A spruce, 3 ins. diam., bears S. 55 1/2° W., 14.7 ft. dist., mkd. X BT.

A hemlock, 2 ins. diam., bears N. 18° W., 18.2 ft. dist., bark scribed X BT.

Deposit a magnet in a white plastic case at the base of the stainless steel post.

Monument is located on steep E slope, among second growth hemlock and occasional spruce, with dense berry bushes, false azalea, and fireweed. The post is set in mineral soil with clay and rocks.

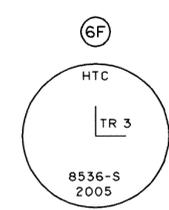


Set a stainless steel post, 28 ins. long, 2 1/2 ins. diam., 22 ins. in the ground, encircled by a rock collar, 12 ins. diam., with brass cap mkd. as shown, from which

A hemlock, 9 ins. diam., bears N. 23 3/4° E., 61.9 ft. dist., mkd. X BT.

A hemlock, 14 ins. diam., bears N. 53 3/4° W., 31.5 ft. dist., mkd. X BT.

Deposit a magnet in a white plastic case at the base of the stainless steel post.

Monument is located on gentle NW slope, among hemlock, with berry bushes. The edge of a clearcut, bears W, 15 ft. dist., edge bears N and S, 25° W. A logging road accessing clearcut bears East, 240 ft. dist., road bears NE and SW. The post is set in organic soil.

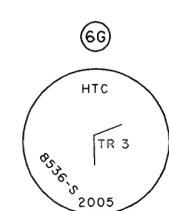


Drive an iron rod, 36 ins. long, 5/8 ins. diam., 5 ins. below the road surface, with alum. cap mkd. as shown, from which

A hemlock, 10 ins. diam., bears S. 89 3/4° E., 60.1 ft. dist., mkd. X BT.

A hemlock, 6 ins. diam., bears S. 32° W., 109.6 ft. dist., mkd. X BT.

Monument is located in the roadway of the White Alice Road. The rebar is set in the construction rock of the road.

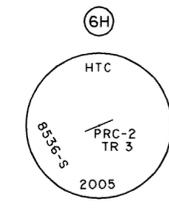


Drive an iron rod, 36 ins. long, 5/8 ins. diam., 6 ins. below the road surface, with alum. cap mkd. as shown, from which

A hemlock, 6 ins. diam., bears S. 32° W., 63.8 ft. dist., mkd. X BT.

A spruce, 11 ins. diam., bears N. 62 1/2° W., 59.3 ft. dist., mkd. X BT.

Monument is located in the roadway of the White Alice Road. The beginning of a spur road bears N. 72° E., 145 ft., spur extends S. 60° E. The rebar is set in the construction rock of the road.

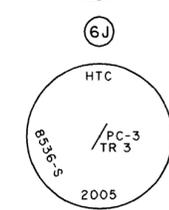


Drive an iron rod, 36 ins. long, 5/8 ins. diam., 6 ins. below the road surface, with alum. cap mkd. as shown, from which

A spruce, 11 ins. diam., bears N. 35 1/2° E., 151.1 ft. dist., mkd. X BT.

A magnet, epoxied into a drill hole, in a vertical face of bedrock, bears N. 69 3/4° E., 51.5 ft. dist., capped with a silver plastic case.

A magnet, epoxied into a drill hole, located in a vertical face of rock cut, 3 ft. below top of cut bank, bears S. 42° E., 30.0 ft. dist., capped with pink plastic case.

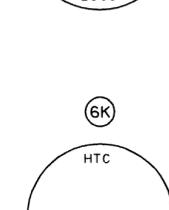


Monument is located in the roadway of the White Alice Road. The rebar is set in the construction rock of the road.

Drive an iron rod, 16 ins. long, 5/8 ins. diam., 3 ins. below the road surface to the point of refusal, with alum. cap mkd. as shown, from which

A spruce, 11 ins. diam., bears N. 36 1/4° E., 63.5 ft. dist., mkd. X BT.


A magnet, epoxied into a drill hole, 4 ins. deep into an outcropping of bedrock, bears N. 49° W., 29.2 ft. dist., capped with an orange plastic case.

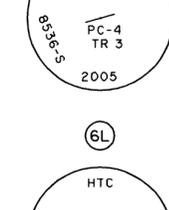

Monument is located in the roadway of the White Alice Road, at rock pit. The rebar is set in the construction rock of the road.


Drive an iron rod, 36 ins. long, 5/8 ins. diam., 6 ins. below the road surface, with alum. cap mkd. as shown, from which

A magnet, epoxied into a drill hole, drilled 2 1/2 ins. into vertical face of bedrock, bears S. 49 3/4° E., 22.7 ft. dist., capped with a pink plastic case.

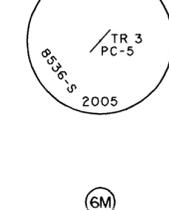

A magnet, epoxied into a drill hole, drilled 2 1/4 ins. into slight overhanging vertical face of bedrock, bears S. 71 1/2° W., 44.6 ft. dist., capped with a blue plastic case.

Monument is located in the roadway of the White Alice Road, in a narrow cut of bedrock. The rebar is set in the construction rock of the road.

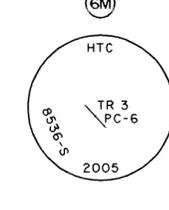

Drive an iron rod, 36 ins. long, 5/8 ins. diam., 5 ins. below the road surface, with alum. cap mkd. as shown, from which

A spruce, 8 ins. diam., bears N. 62° E., 93.1 ft. dist., mkd. X BT.

A poplar, 6 ins. diam., bears South, 49.4 ft. dist., bark scribed X BT.

Monument is located in the roadway of the White Alice Road. The rebar is set in the construction rock of the road.

SITKA 2006-29

Sheet 7 of 11 Sheets  
ALASKA NATIVE CLAIMS SETTLEMENT ACT  
(ANCSA) SECTION 14 (C) TRACTS 1 THROUGH 12  
P.L. 92-203, (85 STAT. 688, 702, 703)

HUNA TOTEM CORPORATION  
AT  
HOONAH, ALASKA  
AND

THE DEPENDENT RESURVEY OF THE SOUTH  
BOUNDARY OF T. 43 S., R. 61 E., C.R.M.,  
THE DEPENDENT RESURVEY OF PORTIONS OF  
U.S. SURVEY Nos. 1899, 1929, 2124, 2414,  
2595, 4539 AND THE RETRACEMENT OF ALASKA  
TIDELANDS SURVEY No. 1261.

REFERENCE SHOULD BE MADE TO  
SHEET No. 1 FOR SURVEY INFORMATION

NOTES

1. The letters "I" and "O" were not used to identify monuments on this sheet.
2. Monument identifiers represent the sheet on which the monument description is located.

MEANDERS TRACT 7





From the true point for the most northwesterly corner of Tract 7, not monumented due to liability of destruction by water action.

Thence with the meanders of Hoonah Harbor, along a gently sloping beach of rocks and gravel, at the line of mean high tide.

1. N. 76°41'32" E., 190.31 ft.
  2. N. 85°57'26" E., 106.93 ft.
- At end of course, the true point for the most northeasterly corner of Tract 7, not monumented due to liability of destruction by water action.

LEGEND

- ✱ Found BLM/GLO Monument
- Set Monument This Survey
- Set 5/8" Diam. Rebar With Alum. Cap This Survey
- ⊕ Found Primary Monument by Others

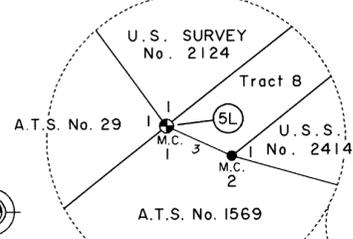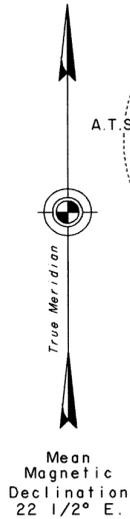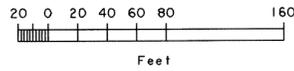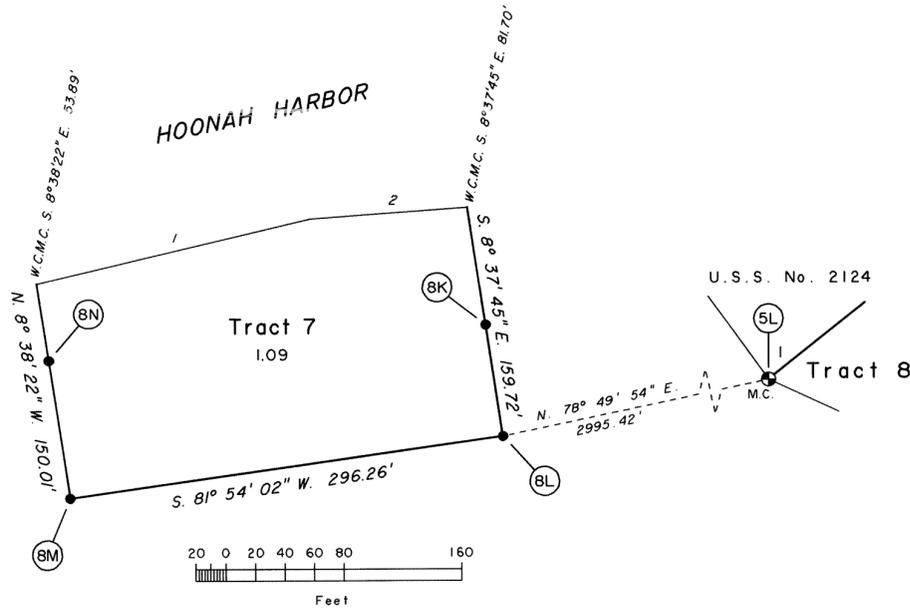

MEANDERS TRACT 8

From the true point for corner No. 4, U.S. Survey No. 2595, identical with corner No. 11, Tract 1, Alaska Tidelands Survey No. 1261 and identical with a corner of Tract 8, all meander corners, monumented as shown.

Thence with the adjusted record meanders of Tract 1, Alaska Tidelands Survey No. 1261, through an area that has been changed by construction of the Hoonah Airport


1. S. 26°19'00" E., 341.27 ft.
2. S. 3°13'45" W., 197.84 ft.

At end of course, the intersection with the adjusted record meanders at a corner of Tract 8, identical with the most NW corner of Tract 9, monumented as shown.

From the true point for corner No. 1, U.S. Survey No. 2124, identical with corner No. 1, Alaska Tidelands Survey No. 29, identical with corner No. 1, Tract B, Alaska Tidelands Survey No. 1569 and identical with a corner of Tract 8, all meander corners, monumented as shown.

Thence with the meanders of Hoonah Harbor, at the line of mean high tide.

3. S. 64°43'35" E., 102.75 ft.
- At end of course, the true point for corner No. 1, U.S. Survey No. 2414, identical with a corner of Tract 8, monumented as shown.

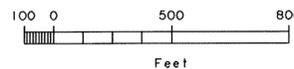

See DETAIL B SHEET 4

See DETAIL B SHEET 4

Tract 4

Sec. 26

Tract 8  
173.08

Tract 11

Tract 12

Tract 9


Sec. 35

ALASKA NATIVE CLAIMS SETTLEMENT ACT (ANCSA) SECTION 14 (C) TRACTS I THROUGH I2 P.L. 92-203, (85 STAT. 688, 702, 703)

HUNA TOTEM CORPORATION AT HOONAH, ALASKA AND

THE DEPENDENT RESURVEY OF THE SOUTH BOUNDARY AND THE RETRACEMENT OF THE EAST BOUNDARY OF T. 43 S., R. 61 E., C.R.M., THE DEPENDENT RESURVEY OF PORTIONS OF U.S. SURVEY Nos. 1899, 1929, 2124, 2414, 2595, 4539 AND THE RETRACEMENT OF ALASKA TIDELANDS SURVEY No. 1261.

REFERENCE SHOULD BE MADE TO SHEET No. 1 FOR SURVEY INFORMATION

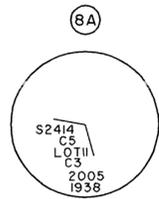


Found an iron post, 1 in. diam., firmly set, projecting 4 ins. above ground, with a brass cap mkd. as shown, from which the remaining original bearing tree

A hemlock, 9 ins. diam., bears S. 77 1/4° W., 110.0 ft. dist., with scribe mks. visible in a partially healed blaze.

and new bearing tree

A spruce, 16 ins. diam., bears S. 73 1/2° E., 29.1 ft. dist., mkd. X BT.

Add the mks. 2005 to the brass cap.

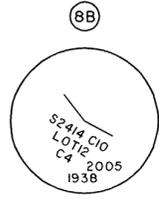

Found an iron post, 1 in. diam., firmly set, projecting 12 ins. above ground, with a brass cap mkd. as shown, from which the original bearing trees


A hemlock snag, 34 ins. diam., bears S. 1 1/2° W., 47.4 ft. dist., with scribe mks. visible in a partially healed blaze.

A hemlock, 26 ins. diam., bears N. 75 1/2° W., 17.5 ft. dist., with a completely healed blaze.

and new bearing tree

A spruce, 21 ins. diam., bears S. 31 3/4° W., 32.7 ft. dist., mkd. X BT.


Add the mks. 2005 to the brass cap.

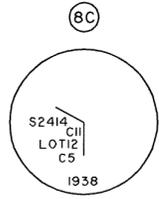

Found an iron post, 1 in. diam., firmly set, projecting 5 ins. above ground, with a brass cap mkd. as shown, from which the original bearing trees

A hemlock, 29 ins. diam., bears S. 58° W., 43.4 ft. dist., with scribe mks. visible in a partially healed blaze.

A hemlock, 44 ins. diam., bears N. 71 1/2° W., 58.1 ft. dist., with a completely healed blaze.

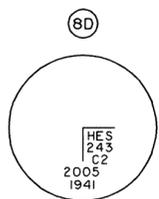


Found an iron post, 1 in. diam., firmly set, projecting 12 ins. above ground, encircled by a rock collar, 15 ins. diam., with a brass cap mkd. as shown, from which the remaining original bearing tree

A hemlock, 19 ins. diam., bears S. 57 1/4° E., 29.3 ft. dist., with a completely healed blaze.

and new bearing tree

A spruce, 17 ins. diam., bears S. 53 1/4° W., 18.7 ft. dist., mkd. X BT.

Add the mks. 2005 to the brass cap.

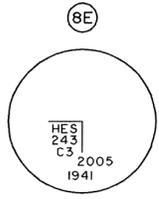

Found an iron post, 1 in. diam., loose and leaning in recently cleared and disturbed area, projecting 24 ins. above ground, with a brass cap mkd. as shown.

No original accessories remaining. Cor. was re-established by Grant Boundary adjustment.


At the corner point, reset the original post, 36 ins. long, 1 in. diam., 19 ins. in the ground, encircled by a rock collar, 20 ins. diam., with a brass cap mkd. as shown, from which

An unmkd. Dept. of Highways brass cap in a monument case, 2 ins. diam., bears S. 34 1/4° W., 121.7 ft. dist., in the center of a white "X" painted on asphalt.

The most SE corner of gray building, 48 ft. x 31 ft., bears N. 61 1/2° W., 184.1 ft. dist., long side bears N. 15° W.

Add the mks. 2005 to the brass cap.

Deposit a magnet in a white plastic case at the base of the iron post.

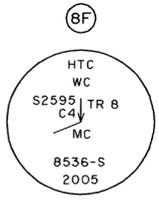

No evidence of the original witness corner at record witness dist. of 56.1 ft. due to 12 ft. of fill for the construction of Taxiway "B".


No original accessories remaining.

Set a stainless steel post, 28 ins. long, 2 1/2 ins. diam., 23 ins. in the ground, encircled by a rock collar, 10 ins. diam., with a brass cap incorrectly mkd. as shown, from which

An unmkd. Dept. of Highways brass cap in a monument case, 2 ins. diam., accepted as true point for corner No. 4, U.S. Survey No. 2595, a meander corner, bears South, 101.0 ft. dist.

An unmkd. Dept. of Highways brass cap in a monument case, 2 ins. diam., bears N. 44° W., 98.4 ft. dist., in the center of a white "X" painted on asphalt.


Deposit a magnet in a white plastic case at the base of the stainless steel post.

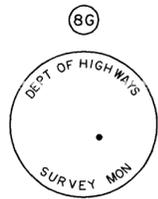

Found a brass cap, 2 ins. diam., firmly set in a monument case at the southerly edge of asphalt in Taxiway "B" of Hoonah Airport, mkd. as shown. No record of this monument was found.

This cor. is accepted as a careful and faithful perpetuation of cor. No. 11, Tract I, Alaska Tidelands Survey No. 1261, which is also accepted as a careful and faithful determination of cor. No. 4, U.S. Survey No. 2595 (H.E.S. No. 243), a meander cor.

No accessories of the 1984 A.T.S. survey remain.

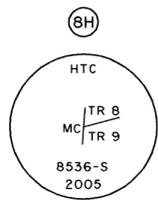


Set a stainless steel post, 28 ins. long, 2 1/2 ins. diam., 22 ins. in the ground, encircled by a rock collar, 14 ins. diam., with brass cap mkd. as shown, from which

A taxiway light, No. 248, bears N. 40° E., 84.2 ft. dist., serial No. 0102266, measured to the most W holding bolt.

A taxiway light, No. 249, bears S. 46 3/4° E., 117.7 ft. dist., serial No. 0203253, measured to the most N holding bolt.

Deposit a magnet in a white plastic case at the base of the stainless steel post.

Monument is located on level ground in the SE corner of the area between the runway, taxiways and farmac, in grass, fireweed, elderberry, cow parsnip and a lone spruce. The post is set in organic soil.

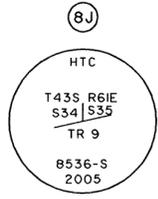


Set a stainless steel post, 28 ins. long, 2 1/2 ins. diam., 23 ins. in the ground, encircled by a rock collar, 18 ins. diam., with brass cap mkd. as shown, from which

A magnet in a silver plastic case, bears N. 45° E., 9.9 ft. dist., buried 12 ins. below ground.

A magnet in an orange plastic case, bears N. 45° W., 9.9 ft. dist., buried 15 ins. below ground.

Deposit a magnet in a white plastic case at the base of the stainless steel post.

Monument is located on gently rolling ground, in grass, fireweed, wild calery and elderberry. The runway centerline bears South, 240 ft., centerline bears N. 78° E. and S. 78° W. The post is set in organic and mineral soils.

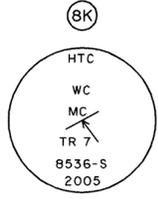


Set a stainless steel post, 28 ins. long, 2 1/2 ins. diam., 22 ins. in the ground, encircled by a rock collar, 8 ins. diam., with brass cap mkd. as shown, from which

A hemlock, 21 ins. diam., bears S. 50 1/2° E., 62.1 ft. dist., mkd. X BT.

A spruce, 25 ins. diam., bears S. 50° W., 41.5 ft. dist., mkd. X BT.

Deposit a magnet in a white plastic case at the base of the stainless steel post.

Monument is located on level ground, among hemlock and spruce, with devil's club and ferns. Top of bank, 3 ft. high, bears N. 8° W., 14 ft. dist., top bears E. and W. The post is set in organic soil.

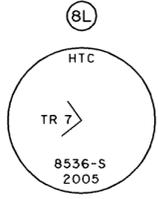


Set a stainless steel post, 28 ins. long, 2 1/2 ins. diam., 23 ins. in the ground, with brass cap mkd. as shown, from which

A spruce, 23 ins. diam., bears S. 41 1/4° W., 18.3 ft. dist., mkd. X BT.

A spruce, 19 ins. diam., bears N. 63 1/4° W., 50.9 ft. dist., mkd. X BT.

Deposit a magnet in a white plastic case at the base of the stainless steel post.

Monument is located on gentle N slope, among spruce and hemlock, with devil's club, deerheart and ferns. The post is set in organic soil.

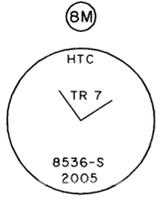


Set a stainless steel post, 28 ins. long, 2 1/2 ins. diam., 23 ins. in the ground, with brass cap mkd. as shown, from which

A hemlock, 14 ins. diam., bears N. 65° E., 12.6 ft. dist., mkd. X BT.

A hemlock, 22 ins. diam., bears N. 51 1/2° W., 18.8 ft. dist., mkd. X BT.

Deposit a magnet in a white plastic case at the base of the stainless steel post.

Monument is located on level ground, among hemlock, with devil's club, berry bushes and ferns. The post is set in organic soil.

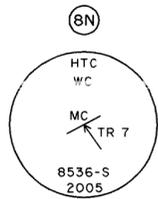


Set a stainless steel post, 28 ins. long, 2 1/2 ins. diam., 22 ins. in the ground, encircled by a rock collar, 12 ins. diam., with brass cap mkd. as shown, from which

A spruce, 30 ins. diam., bears S. 76° E., 20.9 ft. dist., mkd. X BT.

A hemlock, 13 ins. diam., bears S. 29 1/2° W., 28.3 ft. dist., mkd. X BT.

Deposit a magnet in a white plastic case at the base of the stainless steel post.

Monument is located on gentle N slope, at the toe of old bank, 6 ft. high, among hemlock, spruce and alder, with devil's club, berry bushes and ferns. The post is set in organic soil.

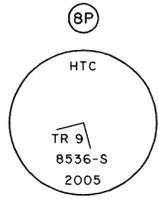


Set a stainless steel post, 28 ins. long, 2 1/2 ins. diam., 18 ins. in the ground, encircled by a rock collar, 14 ins. diam., with brass cap mkd. as shown, from which

A spruce, 5 ins. diam., bears S. 32° W., 18.1 ft. dist., mkd. X BT.

A hemlock, 11 ins. diam., bears N. 73 1/2° W., 11.8 ft. dist., mkd. X BT.

Monument is located on gentle rolling S slope, among hemlock and spruce, with berry bushes of the N clearing limits for airport. The post is set in organic soil with clay.

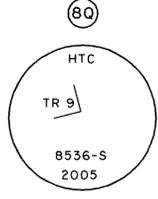


Set a stainless steel post, 28 ins. long, 2 1/2 ins. diam., 22 ins. in the ground, encircled by a rock collar, 12 ins. diam., with brass cap mkd. as shown, from which

A spruce, 15 ins. diam., bears S. 56° E., 58.0 ft. dist., mkd. X BT.

A spruce, 23 ins. diam., bears S. 12 3/4° W., 74.8 ft. dist., mkd. X BT.

Deposit a magnet in a white plastic case at the base of the stainless steel post.

Monument is located on level ground, in grass elderberry, salmonberry and ferns. The post is set in organic soil over clay.

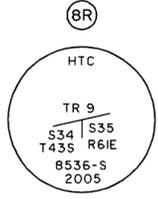


Set a stainless steel post, 28 ins. long, 2 1/2 ins. diam., 22 ins. in the ground, encircled by a rock collar, 12 ins. diam., with brass cap mkd. as shown, from which

A spruce, 4 ins. diam., bears S. 9 1/2° E., 22.0 ft. dist., mkd. X BT.

A magnet in an orange plastic case, bears N. 76° W., 9.7 ft. dist., buried 11 ins. below ground.

Deposit a magnet in a white plastic case at the base of the stainless steel post.

Monument is located on nearly level ground, in grass, on the left bank of slough, 18 ft. wide, bank bears N. 35° W. and S. 35° E. The post is set in organic soil over sand and gravel.

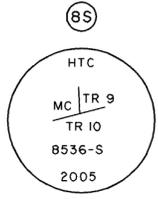


Set a stainless steel post, 28 ins. long, 2 1/2 ins. diam., 25 ins. in the ground, encircled by a rock collar, 18 ins. diam., with brass cap mkd. as shown, from which

An alum. post, 2 1/2 ins. diam., firmly set, projecting 4 ins. above the ground, bears N. 9 1/2° E., 9.6 ft. dist., with alum. cap mkd. DOT/PF ATSI261 C14 S5453 1984.

A spruce, 7 ins. diam., bears S. 62° E., 104.5 ft. dist., mkd. X BT.

Deposit a magnet in a white plastic case at the base of the stainless steel post.


Monument is located on level ground, in grass. The bank of a slough bears S. 12 ft. dist., bank bears N. 55° W. and S. A berm, 6 ft. high, bears E. 95 ft. dist., berm bears N. 35° W. and S. 55° E. The post is set in organic soil over sand.

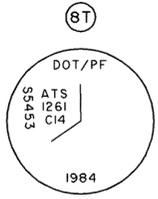

Found an alum. post, 2 1/2 ins. diam., firmly set, projecting 4 ins. above the ground, with alum. cap mkd. as shown, from which

An iron rod, 5/8 ins. diam., bears N. 7 3/4° E., 64.8 ft. dist., with alum. cap mkd. DOT-PF 5435-S RM2 C14 ATSI261 1984. (Record: N. 12°00'55" E., 65.7 ft. dist.)

An iron rod, 5/8 ins. diam., bears S. 78° E., 76.4 ft. dist., with alum. cap mkd. DOT-PF 5435-S RMI C14 ATSI261 1984.

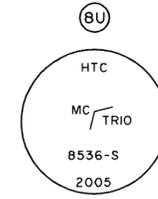

Set a stainless steel post, 28 ins. long, 2 1/2 ins. diam., 22 ins. in the ground, encircled by a rock collar, 18 ins. diam., with brass cap mkd. as shown, from which


A magnet in a silver plastic case, bears N. 41 1/2° E., 8.9 ft. dist., buried 14 ins. below ground.

A magnet in a pink plastic case, bears S. 41° E., 12.1 ft. dist., buried 16 ins. below ground.


Deposit a magnet in a white plastic case at the base of the stainless steel post.

Monument is located on level ground, in grass. Overflow channel of Gartina Creek, 20 ft. wide, bears E. 18 ft. dist., course S. 36° E. and the main channel of Gartina Creek, 75 ft. wide, bears N. 90 ft. dist., course S. 76° W. The post is set in organic soil over gravel and sand.

Found an alum. cap, 2 ins. diam., firmly set, flush with the runway surface, mkd. as shown.

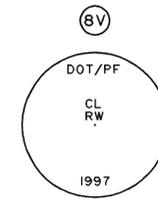

Found an unmkd. Dept. of Highways brass cap, 2 ins. diam., firmly set in a monument case, with a single yellow dot painted near the center of the cap.

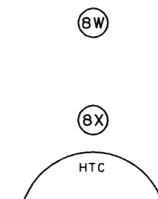


Set a stainless steel post, 28 ins. long, 2 1/2 ins. diam., 24 ins. in the ground, encircled by a rock collar, 12 ins. diam., with brass cap mkd. as shown, from which

A hemlock, 8 ins. diam., bears N. 35 1/2° E., 47.4 ft. dist., mkd. X BT.

A hemlock, 9 ins. diam., bears N. 25° W., 43.0 ft. dist., mkd. X BT.

Deposit a magnet in a white plastic case at the base of the stainless steel post.

Monument is located on gentle SE slope, among hemlock and spruce, with dense berry bushes, false azalea, devil's club and ferns. The post is set in organic soil.

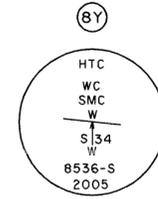

Set a stainless steel post, 28 ins. long, 2 1/2 ins. diam., 22 ins. in the ground, encircled by a rock collar, 14 ins. diam., with brass cap mkd. as shown, from which

A hemlock, 7 ins. diam., bears S. 13 1/4° E., 32.1 ft. dist., mkd. X BT.

A spruce, 4 ins. diam., bears S. 67 3/4° W., 42.9 ft. dist., mkd. X BT.

Deposit a magnet in a white plastic case at the base of the stainless steel post.

True point bears N. 0°03'49" W., 33.80 ft. dist., falls on gravel and mud beach, not monumented due to the liability of destruction by tidal action.

The monument is located on level ground, on the edge of freshme and grassflats of the Gartina Creek estuary. The post is set in organic soil over saturated sand and gravel.

Site 2006-29

Sheet 9 of 11 Sheets  
ALASKA NATIVE CLAIMS SETTLEMENT ACT  
(ANCSA) SECTION 14 (C) TRACTS 1 THROUGH 12  
P.L. 92-203, (85 STAT. 688, 702, 703)

HUNA TOTEM CORPORATION  
AT  
HOONAH, ALASKA  
AND

THE DEPENDENT RESURVEY OF THE SOUTH  
BOUNDARY AND THE RETRACEMENT OF THE EAST  
BOUNDARY OF T. 43 S., R. 61 E., C.R.M.,  
THE DEPENDENT RESURVEY OF PORTIONS OF  
U.S. SURVEY Nos. 1899, 1929, 2124, 2414,  
2595, 4539 AND THE RETRACEMENT OF ALASKA  
TIDELANDS SURVEY No. 1261.

REFERENCE SHOULD BE MADE TO  
SHEET No. 1 FOR SURVEY INFORMATION

**MEANDERS OF REMAINDER OF ORIGINAL LOT 8, SEC. 34**

From the true point for corner No. 13, U.S. Survey No. 2414, identical with the most NW corner of Tract 13, both meander corners, not monumented.

Thence with the meanders of Tract 13, along a gently sloping, cobble and muddy beach, at the line of mean high tide.

1. S. 72°46'11" W., 14.68 ft.
2. S. 10°04'23" E., 51.87 ft. At end of course, the true point for the most NW corner of Tract 12, identical with the most SW corner of Tract 13, not monumented.

**MEANDERS OF TRACT 12 ONLY**

From the true point for the most NW corner of Tract 12, not monumented.

Thence with the meanders of Tract 12, along a gently sloping, cobble and muddy beach, at the line of mean high tide.



1. S. 10°04'24" E., 145.44 ft.
2. S. 79°23'27" E., 255.60 ft. At end of course, corner No. 53, Tract 1, A.T.S. No. 1261, monumented as shown.

**ALASKA TIDELANDS SURVEY No. 1261  
TRACT 2 MEANDERS**

From the corner No. 51, Tract 1, A.T.S. No. 1261.



Thence with the record meanders of Tract 2, A.T.S. No. 1261.

60. S. 49°57'22" W., 181.95 ft.
61. S. 0°55'06" W., 135.65 ft.
62. S. 13°12'58" E., 88.87 ft.
63. S. 81°03'53" E., 92.22 ft.
64. S. 60°19'56" E., 143.36 ft. At end of course, corner No. 1, Tract 2, A.T.S. No. 1261, monumented as shown.
65. S. 59°58'14" E., 139.53 ft.
66. S. 44°10'32" E., 111.29 ft.
67. S. 41°20'10" W., 123.48 ft.
68. N. 87°25'54" W., 63.54 ft. At end of course, corner No. 5, Tract 2, A.T.S. No. 1261, monumented as shown.
69. N. 87°25'50" W., 66.14 ft.
70. N. 79°53'59" W., 100.82 ft.
71. N. 66°07'06" W., 77.32 ft.
72. N. 54°51'33" W., 87.20 ft.
73. N. 70°08'17" W., 130.67 ft. At end of course, the true point for the meander corner of secs. 33 and 34, not monumented.

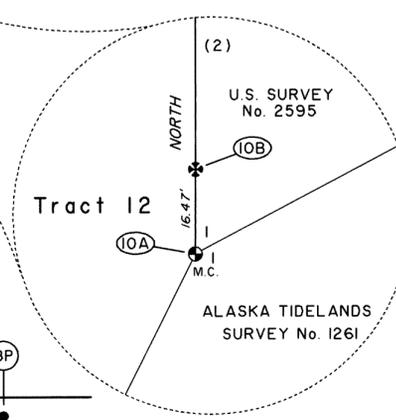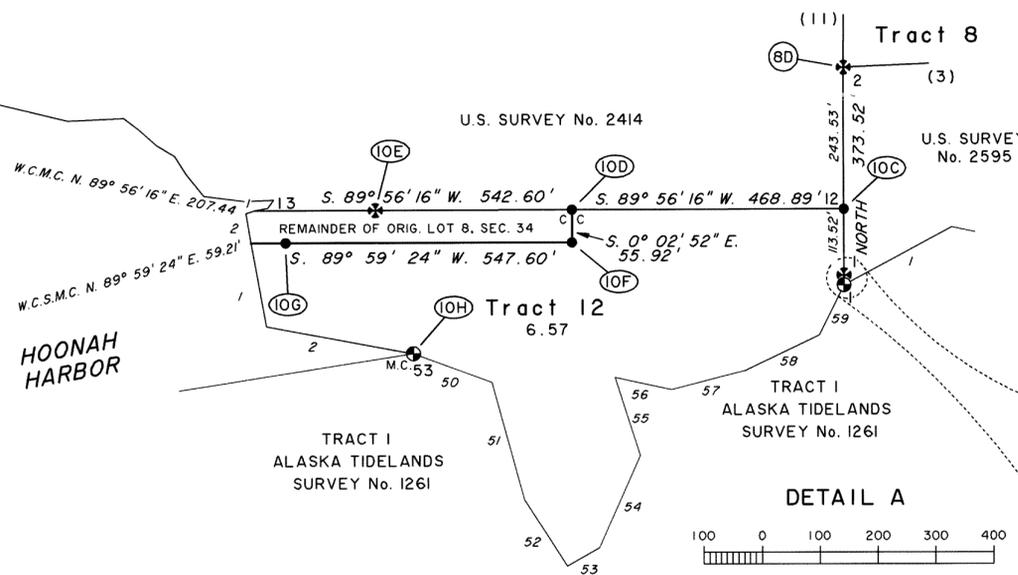

- LEGEND**
- Found BLM/GLO Monument
  - Set Monument This Survey
  - Set 5/8" Diam. Rebar With Alum. Cap This Survey
  - Found Primary Monument by Others

- NOTES**
1. Tract 9 represents that portion of the Quitclaim Deed, dated July 17, 1984, recorded in Book 66, Pages 290 through 292, Sitka Recording District that falls outside the boundaries of Alaska Tidelands Survey No. 1261.
  2. Tract 12 represents that portion of original Lots 7 and 8, sec. 34, as described in Quitclaim Deed, recorded in Book 59, Pages 581 through 583, Sitka Recording District.
  3. Alaska Tidelands Survey No. 1261 meander line was retraced and adjusted for closure.
  4. A portion of the boundaries of Alaska Tidelands Survey No. 1261, identical in part with Tract 10, were remeandered to represent the line of mean high tide.
  5. That portion of the Tract 12 meanders, identical with the adjusted meanders of Tract 1, Alaska Tidelands Survey No. 1261 are included with the adjusted meanders of Tract 1, Alaska Tidelands Survey No. 1261, located on Sheet 10.
  6. The letters "I" and "O" were not be used to identify monuments on this sheet.
  7. Monument identifiers represent the sheet on which the monument description is located.

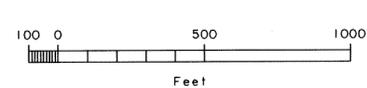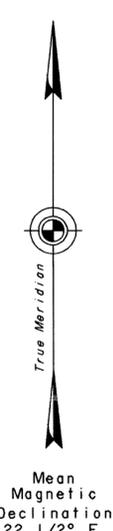

Sec. 33

Sec. 34

KSO/RLG

Sitka 2006-29

HUNA TOTEM CORPORATION  
AT  
HOONAH, ALASKA  
AND

THE DEPENDENT RESURVEY OF THE SOUTH  
BOUNDARY AND THE RETRACEMENT OF THE EAST  
BOUNDARY OF T. 43 S., R. 61 E., C.R.M.,  
THE DEPENDENT RESURVEY OF PORTIONS OF  
U.S. SURVEY Nos. 1899, 1929, 2124, 2414,  
2595, 4539 AND THE RETRACEMENT OF ALASKA  
TIDELANDS SURVEY No. 1261.

REFERENCE SHOULD BE MADE TO  
SHEET No. 1 FOR SURVEY INFORMATION

ALASKA TIDELANDS SURVEY No. 1261  
TRACT I ADJUSTED MEANDERS

From the true point for corner No. 1, Tract I, A.T.S. No. 1261, identical with corner No. 1, U.S. Survey No. 2595 and identical with a corner of Tract 12, all meander corners, monumented as shown.

Thence with the adjusted record meanders of U.S. Survey No. 2595.

- 1. N. 62°01'19" E. 210.67 ft.
- 2. S. 78°08'55" E. 214.58 ft.
- 3. S. 8°16'37" W. 164.25 ft.
- 4. S. 82°38'49" E. 147.90 ft.
- 5. N. 34°00'26" E. 272.76 ft.
- 6. S. 67°38'06" E. 134.01 ft.
- 7. S. 4°55'32" W. 102.25 ft.
- 8. N. 55°05'36" E. 162.47 ft.
- 9. N. 35°18'22" E. 112.27 ft.
- 10. N. 77°20'47" E. 73.30 ft.

At end of course, the true point for corner No. 4, U.S. Survey No. 2595, identical with corner No. 11, Tract I, A.T.S. No. 1261 and identical with a corner of Tract 8, all meander corners, monumented as shown.

Thence with the adjusted record meanders of Tract I, A.T.S. No. 1261, identical with the meanders of Tract 8.

- 11. S. 26°19'00" E. 341.27 ft.
- 12. S. 3°13'45" W. 362.95 ft.

At 197.84 ft., the most NW corner of Tract 9. Continue with the adjusted record meanders of Tract I, A.T.S. No. 1261, identical with the meanders of Tract 9.

At end of course, corner No. 14, Tract I, A.T.S. No. 1261, monumented as shown.

- 13. S. 11°49'50" E. 331.97 ft.
- 14. S. 9°29'58" W. 9.57 ft.

At end of course, a corner of Tract I, A.T.S. No. 1261, identical with the most SW corner of Tract 9 and identical with a corner of Tract 10, monumented as shown.

From the true point for a corner of Tract 10, a meander corner, on the southerly boundary of the Quitclaim Deed, recorded in Book 66, Pages 290 through 292, Sitka Recording District, identified on this plot as "BU", monumented as shown.

Thence with the 2005 meanders.

- 15. S. 1°22'23" E. 152.78 ft.
- 16. S. 14°41'18" W. 213.68 ft.
- 17. S. 67°14'16" W. 208.12 ft.
- 18. N. 57°30'57" W. 132.01 ft.
- 19. S. 66°27'05" W. 75.36 ft.
- 20. N. 71°33'29" W. 178.93 ft.
- 21. N. 84°20'39" W. 85.43 ft.
- 22. S. 15°43'43" W. 303.62 ft.
- 23. S. 28°55'14" E. 304.75 ft.

At end of course, corner No. 27, Tract I, A.T.S. No. 1261, monumented as shown. Thence with the adjusted record meanders of Tract I, A.T.S. No. 1261, identical with the meanders of Tract 10.

- 24. S. 87°22'19" W. 282.93 ft.
- 25. N. 68°27'16" W. 165.88 ft.
- 26. N. 49°29'55" W. 142.65 ft.
- 27. N. 64°40'34" W. 205.02 ft.
- 28. N. 79°32'35" W. 197.56 ft.
- 29. N. 75°17'51" W. 275.80 ft.

At end of course, corner No. 33, Tract I, A.T.S. No. 1261, monumented as shown.

- 30. N. 72°32'50" W. 256.00 ft.
- 31. N. 68°17'26" W. 237.54 ft.
- 32. S. 49°10'30" W. 132.22 ft.
- 33. S. 87°50'20" W. 447.21 ft.

At 276.11 ft., the special meander corner of sec. 34, witnessed as shown on sheet No. 9. Continue with the adjusted record meanders of Tract I, A.T.S. No. 1261, identical with the meanders of sec. 34.

- 34. N. 68°16'39" W. 214.69 ft.
- 35. N. 32°22'36" W. 124.05 ft.
- 36. N. 75°11'33" E. 111.00 ft.

At end of course, corner No. 40, Tract I, A.T.S. No. 1261, monumented as shown.

- 37. N. 56°11'16" E. 220.24 ft.
- 38. N. 42°51'11" E. 128.16 ft.
- 39. N. 1°34'32" W. 99.88 ft.
- 40. N. 71°30'04" E. 134.02 ft.
- 41. N. 3°03'35" E. 160.97 ft.
- 42. S. 76°07'07" W. 230.03 ft.
- 43. N. 47°51'44" W. 116.61 ft.

At end of course, corner No. 47, Tract I, A.T.S. No. 1261, monumented as shown.

- 44. N. 61°31'30" W. 128.95 ft.
- 45. S. 83°36'40" W. 155.03 ft.
- 46. N. 82°56'32" W. 240.51 ft.
- 47. N. 86°42'37" W. 285.02 ft.

At end of course, corner No. 51, Tract I, A.T.S. No. 1261, monumented as shown.






- 48. N. 12°33'07" W. 147.62 ft.
- 49. N. 81°01'35" E. 2134.82 ft.

At end of course, corner No. 53, Tract I, A.T.S. No. 1261, monumented as shown.

Continue with the adjusted record meanders of Tract I, A.T.S. No. 1261, identical with the meanders of Tract 12.

- 50. S. 69°27'00" E. 143.05 ft.
- 51. S. 15°09'52" E. 212.39 ft.
- 52. S. 32°41'17" E. 134.97 ft.
- 53. N. 60°22'16" E. 63.60 ft.
- 54. N. 23°47'31" E. 174.30 ft.
- 55. N. 17°52'35" W. 142.73 ft.
- 56. S. 77°46'13" E. 100.24 ft.
- 57. N. 75°29'27" E. 130.86 ft.
- 58. N. 64°34'55" E. 141.85 ft.
- 59. N. 25°22'50" E. 96.43 ft.

At end of course, the true point for corner No. 1, Tract I, A.T.S. No. 1261, identical with corner No. 1, U.S. Survey No. 2595 and identical with a corner of Tract 12, all meander corners, and point of beginning.

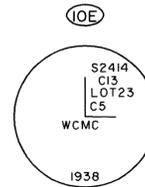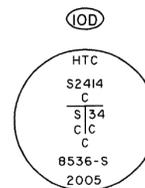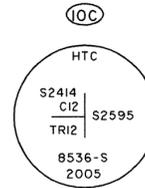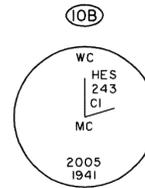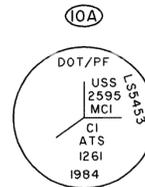

Found cor. No. 1, U.S. Survey No. 2595, a meander cor., identical with cor. No. 1, Tract I, A.T.S. No. 1261, determined by Robert J. Hungertford, Alaska Registered Land Surveyor No. 5453-S, during the 1980-1985 survey of Alaska Tidelands Survey No. 1261, monumented with an alum. post, 2 1/2 ins. diam., firmly set, flush with the ground, with alum. cap mkd. as shown, from which the only remaining 1984 bearing tree

A hemlock, 26 ins. diam., bears N. 69° W., 49.7 ft. dist., with an alum. tag nailed in a partially healed blaze.

This cor. is accepted as a careful and faithful determination of the cor. point and now also becomes a cor. of Tract 12.

Found an iron post, 1 in. diam., firmly set, projecting 6 ins. above ground, with a brass cap mkd. as shown, from which no original accessories remain.

A spruce, 9 ins. diam., bears S. 70 1/4° W. 36.2 ft. dist., mkd. X BT.

A spruce, 13 ins. diam., bears N. 13 1/4° W. 34.3 ft. dist., mkd. X BT.

Add the mks. 2005 to the brass cap.

No evidence of the original monument due to home construction and lot clearing; position determined at record bearing and distance from the remaining original bearing tree

A hemlock, 9 ins. diam., bears N. 77 3/4° W., 39.1 ft. dist., with a completely healed blaze.

At the corner point,

Set a stainless steel post, 28 ins. long, 2 1/2 ins. diam., 22 ins. in the ground, encircled by a rock collar, 20 ins. diam., with a brass cap mkd. as shown, from which a new bearing tree

A spruce, 17 ins. diam., bears S. 5° W., 71.1 ft. dist., mkd. X BT.

Deposit a magnet in a white plastic case at the base of the stainless steel post.

Set a stainless steel post, 28 ins. long, 2 1/2 ins. diam., 20 ins. in the ground, encircled by a rock collar, 12 ins. diam., with brass cap mkd. as shown, from which

A spruce, 24 ins. diam., bears S. 61 1/2° E., 3.7 ft. dist., mkd. X BT.

A spruce, 9 ins. diam., bears N. 15 1/2° W., 17.6 ft. dist., mkd. X BT.







Deposit a magnet in a white plastic case at the base of the stainless steel post.

Monument is located on level ground, among spruce and hemlock, with berry bushes, false azalea, devil's club and ferns. The post is set in saturated organic soil.

Found an iron post, 1 in. diam., firmly set, projecting 6 ins. above ground, with a brass cap mkd. as shown, from which the original bearing trees

A hemlock, 15 ins. diam., bears N. 52 1/4° E., 19.2 ft. dist., with a completely healed blaze.

A spruce, 11 ins. diam., bears N. 77 1/4° E., 55.2 ft. dist., with a completely healed blaze.

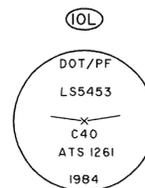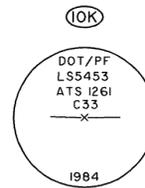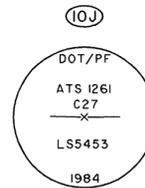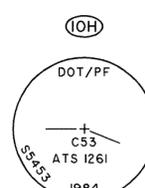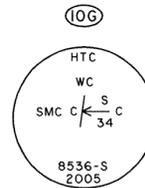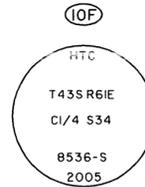

Set a stainless steel post, 28 ins. long, 2 1/2 ins. diam., 20 ins. in the ground, encircled by a rock collar, 14 ins. diam., with brass cap mkd. as shown, from which

A hemlock, 7 ins. diam., bears S. 28 1/2° W., 27.4 ft. dist., mkd. X BT.

A hemlock, 15 ins. diam., bears N. 62 1/2° W., 27.4 ft. dist., mkd. X BT.

Deposit a magnet in a white plastic case at the base of the stainless steel post.

Monument is located on level ground, among spruce and hemlock, with berry bushes, false azalea, devil's club and ferns. The post is set in saturated organic soil.

Set a stainless steel post, 28 ins. long, 2 1/2 ins. diam., 25 ins. in the ground, encircled by a rock collar, 24 ins. diam., with brass cap mkd. as shown, from which

A spruce, 25 ins. diam., bears S. 79 1/2° E., 82.5 ft. dist., mkd. X BT.

A spruce, 16 ins. diam., bears N. 10 3/4° W., 153.9 ft. dist., mkd. X BT.

Deposit a magnet in a white plastic case at the base of the stainless steel post.

True point bears S. 89°59'24" W., 59.21 ft. dist., falls on gravelly beach, not monumented due to the liability of destruction by tidal action.

Monument is located on level ground, in grasses and berry bushes. The post is set in organic soil over clay.

Found an alum. post, 2 1/2 ins. diam., firmly set, projecting 9 ins. above the ground, with alum. cap mkd. as shown, from which

An iron rod, 5/8 in. diam., bears N. 49 1/2° E. 91.3 ft. dist., with alum. cap mkd. RM2 C53 ATS 1261 1984 LS5453.

An iron rod, 5/8 in. diam., bears N. 40 3/4° W. 90.9 ft. dist., with alum. cap mkd. RM-1 C53 ATS 1261 1984 LS5453.

Found an alum. post, 2 1/2 ins. diam., firmly set, projecting 4 ins. above the ground, with alum. cap mkd. as shown, from which

An iron rod, 5/8 in. diam., bears S. 17 1/4° E. 54.2 ft. dist., with alum. cap mkd. DOTPF RMI ATS 1261 C27 1984 5453S.

An iron rod, 5/8 in. diam., bears S. 65° W. 80.2 ft. dist., with alum. cap mkd. DOTPF RM2 ATS 1261 C27 1984 5453S.





Found an alum. post, 2 1/2 ins. diam., firmly set, projecting 3 ins. above the ground, with alum. cap mkd. as shown, from which

An iron rod, 5/8 in. diam., bears S. 13 1/2° E. 52.5 ft. dist., with alum. cap mkd. DOTPF RMI ATS 1261 C33 1984 5453S.

An iron rod, 5/8 in. diam., bears S. 76 1/4° W. 69.9 ft. dist., with alum. cap mkd. RM2 ATS 1261 C33 1984.

Found an alum. post, 2 1/2 ins. diam., firmly set, flush with the the ground, with alum. cap mkd. as shown, from which the remaining accessory

An iron rod, 5/8 in. diam., bears N. 77 3/4° W. 66.2 ft. dist., with alum. cap mkd. DOTPF RMI ATS 1261 C40 1984 5453S.

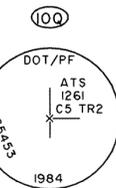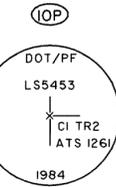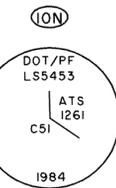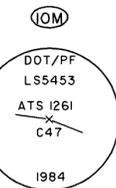

Found on alum. post, 2 1/2 ins. diam., firmly set, projecting 4 ins. above the ground, with alum. cap mkd. as shown, from which

An iron rod, 5/8 in. diam., bears S. 5° W. 82.8 ft. dist., with alum. cap mkd. DOTPF RM2 ATS 1261 1984 5453S.

An iron rod, 5/8 in. diam., bears N. 85° W. 79.0 ft. dist., with alum. cap mkd. DOTPF RMI ATS 1261 C47 1984 5453S. (Record: 80.9 ft. dist.)

Found on alum. post, 2 1/2 ins. diam., firmly set, projecting 5 ins. above the ground, with alum. cap mkd. as shown, from which

An iron rod, 5/8 in. diam., bears S. 34 3/4° E. 17.8 ft. dist., with alum. cap mkd. DOTPF RMI ATS 1261 C51 1984 5453S.

An iron rod, 5/8 in. diam., bears S. 55 1/2° W. 29.7 ft. dist., with alum. cap mkd. DOTPF RM2 ATS 1261 C51 1984 5453S.

Found on alum. post, 2 1/2 ins. diam., firmly set, projecting 5 ins. above the ground, with alum. cap mkd. as shown, from which

An iron rod, 5/8 in. diam., bears N. 1° E. 7.6 ft. dist., with corroded alum. cap mkd. 1984.

An iron rod, 5/8 in. diam., bears S. 89° E. 13.9 ft. dist., with corroded alum. cap mkd. 5453S.

Found on alum. post, 2 1/2 ins. diam., firmly set, projecting 4 ins. above the ground, with alum. cap mkd. as shown, from which

An iron rod, 5/8 in. diam., bears S. 17 3/4° E. 39.3 ft. dist., with no cap.

An iron rod, 5/8 in. diam., bears S. 72 1/2° W. 80.2 ft. dist., with no cap.

Found on alum. post, 1 in. diam., firmly set, projecting 5 ins. above the ground, with alum. cap mkd. as shown, from which

A hemlock, 22 ins. diam., bears S. 31 1/4° E. 53.2 ft. dist., with a tag mkd. BT DOTPF ATSI261 C20 nailed into partially healed blaze.

A spruce, 24 ins. diam., bears S. 33 1/2° W. 53.8 ft. dist., with a tag nailed into partially healed blaze.

NOTES


1. The record bearing of the twelfth meander course (S. 3°12'29" E.) of Tract I, Alaska Tidelands Survey No. 1261, appears to have a typographical error. During the adjustment of this survey, the bearing of S. 3°12'29" W. was used.
2. The letters "I" and "O" were not be used to identify monuments on this sheet.

Sheet 11 of 11 Sheets  
ALASKA NATIVE CLAIMS SETTLEMENT ACT  
(ANCSA) SECTION 14 (C) TRACTS I THROUGH 12  
P.L. 92-203, (85 STAT. 688, 702, 703)

HUNA TOTEM CORPORATION  
AT  
HOONAH, ALASKA  
AND

THE DEPENDENT RESURVEY OF THE SOUTH  
BOUNDARY AND THE RETRACEMENT OF THE EAST  
BOUNDARY OF T. 43 S., R. 61 E., C.R.M.,  
THE DEPENDENT RESURVEY OF PORTIONS OF  
U.S. SURVEY Nos. 1899, 1929, 2124, 2414,  
2595, 4539 AND THE RETRACEMENT OF ALASKA  
TIDELANDS SURVEY No. 1261.

REFERENCE SHOULD BE MADE TO  
SHEET No. 1 FOR SURVEY INFORMATION

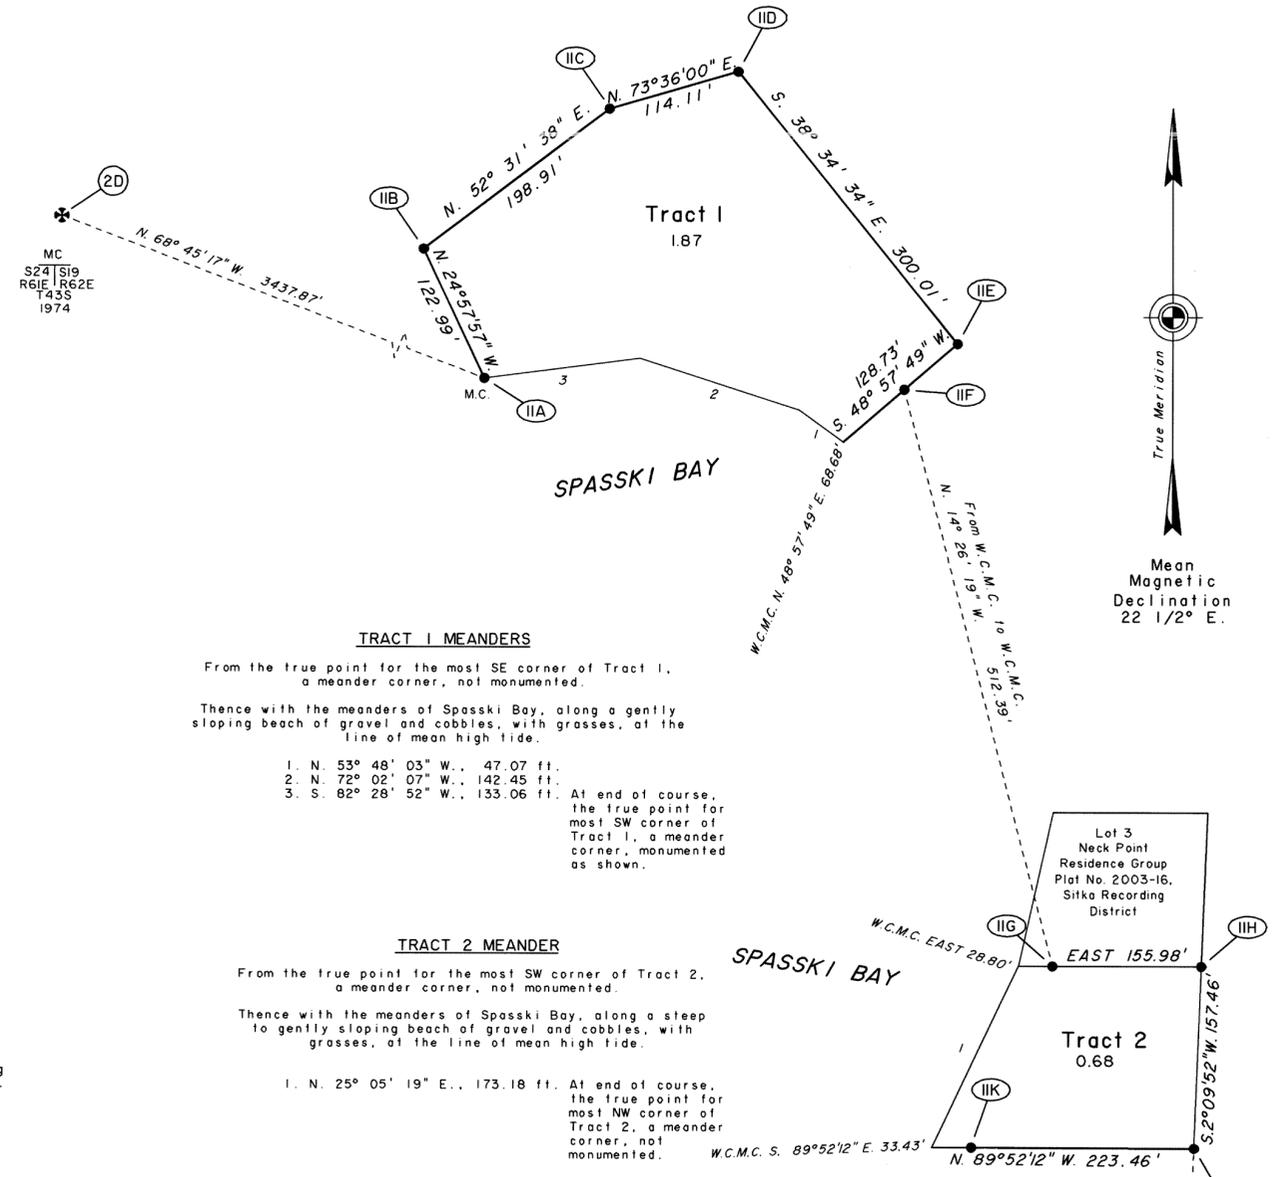

TRACT 1 MEANDERS

From the true point for the most SE corner of Tract 1, a meander corner, not monumented.  
Thence with the meanders of Spasski Bay, along a gently sloping beach of gravel and cobbles, with grasses, at the line of mean high tide.

- 1. N. 53° 48' 03" W., 47.07 ft.
- 2. N. 72° 02' 07" W., 142.45 ft.
- 3. S. 82° 28' 52" W., 133.06 ft.

At end of course, the true point for most SW corner of Tract 1, a meander corner, monumented as shown.

TRACT 2 MEANDER

From the true point for the most SW corner of Tract 2, a meander corner, not monumented.  
Thence with the meanders of Spasski Bay, along a steep to gently sloping beach of gravel and cobbles, with grasses, at the line of mean high tide.


- 1. N. 25° 05' 19" E., 173.18 ft.

At end of course, the true point for most NW corner of Tract 2, a meander corner, not monumented.


NOTES

- 1. Tract 1 was surveyed according to Statutory Warranty Deed, dated July 14, 1992, recorded in Book 98, Page 478, Sitka Recording District. Tract 1 configuration represents the location of all originally staked corners found and are accepted as a careful and faithful determination of the corner points. All corners were remonumented as shown and original stakes are included in corner descriptions.
- 2. Tract 2 was surveyed according to the description of Lot 2 in the Corrective Statutory Warranty Deed, dated June 30, 1998. Tract 2 configuration represents the location of all previously staked corners found and are accepted as a careful and faithful determination of the corner points. All were remonumented as shown and original stakes are included in corner descriptions.
- 3. The letter "I" was not used to identify monuments on this sheet.
- 4. Monument identifiers represent the sheet on which the monument description is found.


2006-29  
Sitka REC. DIST  
DATE 12-19 2006  
TIME 8:36 A.M.  
Requested By US Dept of Interior  
Address Interior

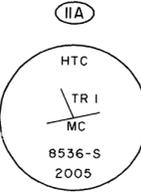


Set a stainless steel post, 28 ins. long, 2 1/2 ins. diam., 22 ins. in the ground, encircled by a rock collar, 12 ins. diam., with brass cap mkd. as shown, from which  
A spruce, 35 ins. diam., bears N. 18 1/2° E., 92.0 ft. dist., mkd. X BT.  
A spruce, 25 ins. diam., bears N. 82° W., 22.9 ft. dist., mkd. X BT.  
Deposit a magnet in a white plastic case at the base of the stainless steel post.  
Monument is located on gentle S slope at freeline of spruce, with vetch and beach grass. The post is set in gravel. Set 1 in. pipe as guard stake.

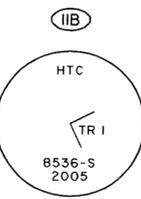


Set a stainless steel post, 28 ins. long, 2 1/2 ins. diam., 19 ins. in the ground, encircled by a rock collar, 12 ins. diam., with brass cap mkd. as shown, from which  
A spruce, 19 ins. diam., bears S. 85 1/4° E., 89.6 ft. dist., mkd. X BT.  
A spruce, 9 ins. diam., bears S. 16 1/4° W., 64.6 ft. dist., mkd. X BT.  
Deposit a magnet in a white plastic case at the base of the stainless steel post.  
Monument is located on level ground, in beach grass, cow parsnip, fireweed and yarrow. The post is set in gravel with sand. Set 1 1/4 ins. pipe as guard stake.

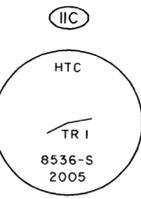


Set a stainless steel post, 28 ins. long, 2 1/2 ins. diam., 22 ins. in the ground, encircled by a rock collar, 8 ins. diam., with brass cap mkd. as shown, from which  
A spruce, 36 ins. diam., bears S. 77° E., 36.7 ft. dist., mkd. X BT.  
A spruce, 9 ins. diam., bears N. 15° W., 32.9 ft. dist., mkd. X BT.  
Deposit a magnet in a white plastic case at the base and 3/8 in. rebar alongside of the stainless steel post.  
Monument is located on shoulder of small rise, rise bears N. 60° W. and S. 14° E., among spruce, with devil's club and deerheart. The NE cor. of dilapidated outhouse, 6 ft. x 5 ft., bears S. 45° E., 6.1 ft. dist., long side bears S. 75° W. The post is set in organic soil with rocks.

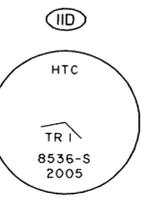

Set a stainless steel post, 28 ins. long, 2 1/2 ins. diam., 21 ins. in the ground, encircled by a rock collar, 12 ins. diam., with brass cap mkd. as shown, from which  
A hemlock, 28 ins. diam., bears N. 77° E., 63.8 ft. dist., mkd. X BT.  
A spruce, 21 ins. diam., bears S. 3 1/4° E., 46.5 ft. dist., mkd. X BT.  
Deposit a magnet in a white plastic case at the base and 3/8 in. rebar alongside of the stainless steel post.  
Monument is located on gently rolling ground, among spruce and hemlock, with devil's club and deerheart. The intersection of two well-defined trails bears S. 66° E., 12 ft. dist., one trail, 2 ft. wide, bears N. 55° E. and S. 55° W., another trail, 3 ft. wide, bears S. 5° E. The post is set in organic soil.

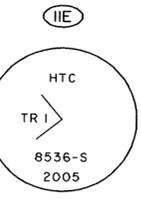


Set a stainless steel post, 28 ins. long, 2 1/2 ins. diam., 22 ins. in the ground, encircled by a rock collar, 12 ins. diam., with brass cap mkd. as shown, from which  
A spruce, 10 ins. diam., bears S. 16 1/4° E., 16.4 ft. dist., mkd. X BT.  
A spruce, 17 ins. diam., bears N. 62° W., 10.7 ft. dist., mkd. X BT.  
Deposit a magnet in a white plastic case at the base and 3/8 in. rebar alongside of the stainless steel post.  
Monument is located on gently rolling ground, among spruce, with deerheart, devil's club and ferns. A trail, 2 ft. wide, bears S. 49° W., 29 ft. dist., trail bears N. 54° W. and S. 32° E. The post is set in organic soil with gravel.

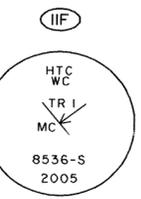


Set a stainless steel post, 28 ins. long, 2 1/2 ins. diam., 22 ins. in the ground, encircled by a rock collar, 12 ins. diam., with brass cap mkd. as shown, from which  
A spruce, 14 ins. diam., bears N. 61 1/4° E., 13.0 ft. dist., mkd. X BT.  
A spruce, 13 ins. diam., bears N. 34° W., 41.4 ft. dist., mkd. X BT.  
Deposit a magnet in a white plastic case at the base of the stainless steel post.  
Monument is located on gentle S slope, among spruce and alder, with devil's club, deerheart and grasses. The post is set in mineral soil.


From this point, a rebar, 3/8 in. diam., firmly set and representing the true cor. of Tract 1, a meander cor., bears S. 48° 57' 49" W., 68.68 ft. dist.

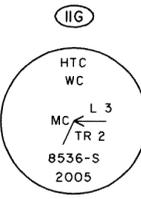

Found an iron rod, 41 ins. long, 5/8 ins. diam., firmly set, projecting 12 ins. above ground, with orange plastic cap mkd. D FINLEY LS6277.  
At the cor. point,  
Remove and destroy Finley monument. Set a stainless steel post, 28 ins. long, 2 1/2 ins. diam., 21 ins. in the ground, encircled by a rock collar, 12 ins. diam., with brass cap mkd. as shown, from which  
The most SE post at edge of deck, 6 ins. x 6 ins., bears N. 62 1/2° E., 28.1 ft. dist.  
A spruce, 10 ins. diam., bears S. 46° E., 46.7 ft. dist., mkd. X BT.  
Deposit a magnet in a white plastic case at the base of the stainless steel post.  
Monument is located on level ground, in grass. The post is set in mineral soil.

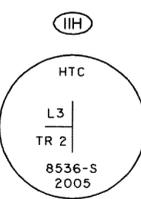


Found steel tubing, 30 ins. long, 3/4 ins. diam., firmly set, projecting 9 ins. above ground, with red plastic cap mkd. DOUG FINLEY LS6277.  
At the corner point,  
Set a stainless steel post, 28 ins. long, 2 1/2 ins. diam., 22 ins. in the ground, encircled by a rock collar, 12 ins. diam., with brass cap mkd. as shown, from which  
A hemlock, 11 ins. diam., bears S. 7° W., 11.5 ft. dist., mkd. X BT.  
A hemlock, 8 ins. diam., bears N. 22 1/2° W., 16.9 ft. dist., mkd. X BT.  
Deposit a magnet in a white plastic case at the base and the steel tubing alongside of the stainless steel post.  
Monument is located on steep NE slope, among hemlock and spruce, with deerheart, false azalea and ferns. The post is set in organic soil.

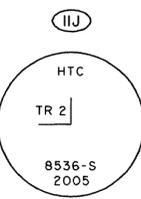

Establish cor. at single proportionate dist. There is no evidence of original cor. stake.  
At the cor. point,  
Set a stainless steel post, 28 ins. long, 2 1/2 ins. diam., 19 ins. in the ground, with brass cap mkd. as shown, from which  
A hemlock, 8 ins. diam., bears N. 2° E., 24.7 ft. dist., mkd. X BT.  
A spruce, 9 ins. diam., bears S. 80° W., 26.4 ft. dist., mkd. X BT.  
Deposit a magnet in a white plastic case at the base of the stainless steel post.  
Monument is located on gentle W slope, among hemlock and spruce, with no understory. The post is set in organic soil.  
From this point, a post, 4 ins. x 4 ins., bears S. 2° 09' 52" W., 165.4 ft. dist., mkd. I MC3.


- LEGEND
- Found BLM/GLO Monument
  - Set Monument This Survey
  - Set 5/8" Diam. Rebar With Alum. Cap This Survey
  - Found Primary Monument by Others

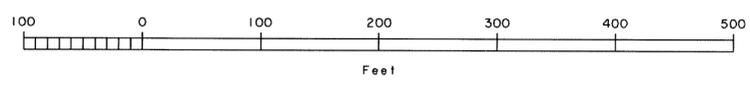



# United States Department of the Interior

BUREAU OF LAND MANAGEMENT  
ALASKA STATE OFFICE  
222 W. 7<sup>th</sup> Avenue, #13  
ANCHORAGE, ALASKA 99513-7599

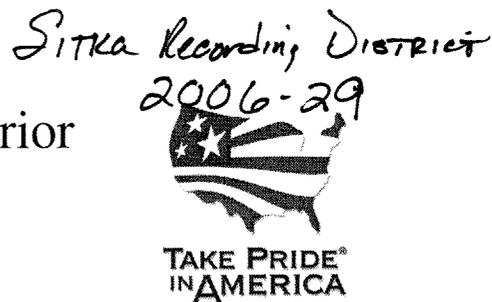

9600 (927)  
ANCSA 14(c)  
HOONAH

December 5, 2006

SITKA RECORDING DISTRICT  
210-C Lake Street  
Sitka, AK 99835

Dear District Recorder:

The ANCSA 14(c) plat for HUNA TOTEM CORPORATION at HOONAH, consisting of eleven (11) original sheets, transmitted to you by this letter of compliance, portrays a Cadastral Survey conducted to fulfill statutory requirements mandated by the Alaska Native Claims Settlement Act (ANCSA), pursuant to Public Law 92-203 (Stat. 688, 702, 703), and satisfies the federal guidelines and requirements proclaimed for ANCSA 14(c) Surveys.

The plat represents surveyed parcels of land selected for ANCSA 14(c) reconveyances situated on portions of surface estate lands transferred from the United States of America by Patent Nos. 50-89-0539 and 50-90-0299, both issued to Huna Totem Corporation.

ANCSA 14(c) Surveys have been authorized as federally mandated surveys, under the provisions of Section 13 of ANCSA, 43 U.S.C. Stat. 1612. The authority to execute all federal land surveys in Alaska is delegated by the Secretary of the Interior to the Director, Bureau of Land Management (BLM) and subsequently redelegated to the Deputy State Director for Cadastral Survey, Alaska State Office. Accordingly, BLM requests that this plat be filed with the SITKA RECORDING DISTRICT to comply with the federal platting regulations and the agreements set forth between the Bureau of Land Management and the State Recording Authority.

Sincerely,

John Sroufe  
Deputy State Director  
for Cadastral Survey, Alaska