ORIGINAL

I hereby certify that Lots 1 through 42, represented on this plat of survey are on lands Interim Conveyed to the Nelson Lagoon Corporation by Interim Conveyance No. 167 issued by the United States of America; said lots also fulfill all entitlements under the provisions of ANCSA 14(c) as requested by the Nelson Lagoon Corporation Resolution Agreement No. 1-87, and the Nelson Lagoon ANCSA 14(c) Map of Boundaries approved June 18, 1988.

6-1-92
Date

Paul E. Gold
President, Nelson Lagoon Corporation

AMENDMENT NOTE:

See sheet 3 of 10, a bearing quadrant correction by Willard M. Olson, Cadastral Surveyor, in 1996.

14(c) ROAD RIGHTS-OF-WAYS

COMPRISING 3 LOTS

LOT 19

EASY STREET AREA: 3.96 ACRES

LOT 32

AIRPORT WAY
SEGMENT (b) AREA: 1.19 ACRES

LOT 33

AIRPORT WAY SEGMENT (a)
STORSETH ROAD
COUNTRY ROAD
TUCHKIN DRIVE
EAST SHERMAN DRIVE
SHERMAN DRIVE
MOON DRIVE
NELSON LAGOON DRIVE
NORTH BEACH ACCESS ROAD
BEARING WAY
NORTH MAIN DRIVE
SOUTH MAIN DRIVE
CEMETERY ACCESS ROAD

AREA: 14.95 ACRES

TOTAL AREA: 20.10 ACRES

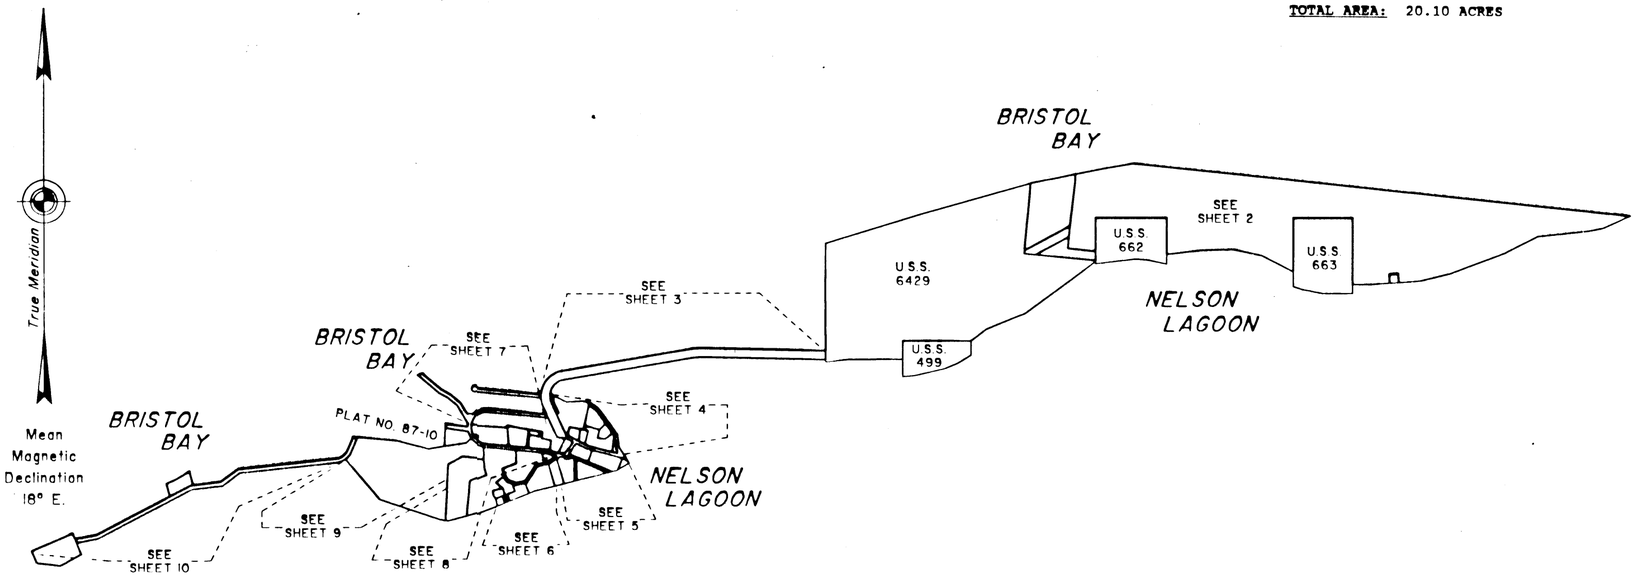

92-24
RECORDED - FILED 65 cc
ALEUTIAN IS REC DIST.
DATE 6-16 1992
TIME 10:30 A M
Requested by (USA/BLM)
Address

UTILITY EASEMENTS

ALL OF THE UTILITY EASEMENTS SURVEYED AT NELSON LAGOON WERE FOUND ABOVE THE GROUND OR STAKED BY THE NELSON LAGOON CORPORATION BASED UPON THE MAP OF BOUNDARIES APPROVED JUNE 18, 1988. THIS SURVEY IS NOT AN AS-BUILT FOR ANY BURIED UTILITIES. THE ACTUAL BURIED UTILITY LINE MAY VARY FROM THE UTILITY EASEMENTS STAKED AT THE TIME OF SURVEY.

I, Willard M. Olson, Cadastral Surveyor, HEREBY CERTIFY upon honor that I have executed the ANCSA 14(c) Survey depicted on this plat, sheets 1 - 10, in conformity with the Special Instructions approved August 1, 1988, the principles of survey described in the Manual of Surveying Instructions, 1973, and in the specific manner described on this plat.

5/20/1992
Date

Willard M. Olson
Cadastral Surveyor

RJC

Sheet 1 of 10

ALASKA NATIVE CLAIMS SETTLEMENT ACT (ANCSA) SECTION 14(c), LOTS 1 THROUGH 42 (P.L. 92-203, 85 STAT. 688, 702, 703) NELSON LAGOON CORPORATION AT NELSON LAGOON, ALASKA AND THE DEPENDENT RESURVEY AND RETRACEMENTS OF PORTIONS OF NELSON LAGOON SCHOOL SITE; AND THE RETRACEMENTS OF PORTIONS OF U.S. SURVEYS NOS. 662, 663, AND 6429 THE NELSON LAGOON WATER TANK SITE THE WATERLINE CORRIDOR, AND THE NELSON LAGOON TOWNSITE, WEST ADDITION

This plat contains the entire survey record.

The dependent resurvey of U.S. Survey Nos. 662 and 663; the survey of the meanders and the islands of Township 48 South, Range 76 West, Seward Meridian, Alaska; and the survey of the Twelfth Standard Parallel South along the south boundary, the Nineteenth Guide Meridian West along the east boundary, and meanders of Township 48 South, Range 77 West, Seward Meridian, Alaska, were executed by Charles E. Akin, Jr., Cadastral Surveyor, in 1979.

U.S. Survey Nos. 662 and 663 were surveyed by Alexander H. Bradford, U.S. Deputy Surveyor, in 1917.

U.S. Survey No. 6429 was surveyed by Charles E. Akin, Jr., Cadastral Surveyor, in 1979.

The Nelson Lagoon School Site was surveyed by William P. Hamm, Registered Alaska Land Surveyor No. 3310/S, in 1979.

The Water Tank Site and the Waterline Corridor were surveyed by Gary A. Crenshaw, Registered Alaska Land Surveyor No. 4277/S, in 1985 and recorded in 1986, book 25, pages 831 through 838, Aleutian Islands Recording District.

The Nelson Lagoon Townsite, West Addition, was surveyed by Gary D. Drasky, Registered Alaska Land Surveyor No. 2234/S, in 1987.

This survey was executed by Willard M. Olson, Cadastral Surveyor, September 4 through September 20, 1988, in accordance with the principles set forth in the Manual of Surveying Instructions, 1973, Special Instructions approved August 1, 1988; the Nelson Lagoon (ANCSA) 14(c) Map of Boundaries approved June 18, 1988, and Assignment Instructions dated August 1, 1988.

Field assistants were:
Scott L. Twenhofel, Land Surveyor
Douglas R. Gardner, Land Surveyor
Michael J. Nordin, Land Surveyor
Stephen B. Hamrick, Land Surveyor
Robert W. Puryear, Land Surveyor
Allen Minish, Land Surveyor
Daniel R. Ontiveros, Student Trainee (LS)

Area: 184.13 Acres.

The azimuth was obtained from a direct observation of the sun and refers to the true meridian.

The geographic position of corner No. 2, ANCSA 14(c) Lot 22, as determined from a tie to U.S. Coast and Geodetic Survey triangulation station "YARD 1979," is:

Latitude: 56° 00' 06.25" North
Longitude: 161° 12' 06.68" West
NAD 27

The mean magnetic declination was obtained from the plat of Township 48 South, Range 76 West, Seward Meridian, Alaska, accepted September 15, 1982.

This survey is situated in and around the village of Nelson Lagoon, Alaska, Township 48 South, Range 76 West, Seward Meridian, Alaska.

The land is flat with rolling sand mounds; the soil is silt and sand partially covered with native grasses.

UNITED STATES DEPARTMENT OF THE INTERIOR
BUREAU OF LAND MANAGEMENT
Anchorage, Alaska

The survey represented by this plat, sheets 1 - 10, having been properly executed and examined, is hereby accepted for having fulfilled the requirements of Section 14(c) of the Alaska Native Claims Settlement Act.

For the Director

George B. Pratt 5 JUNE 1992
Date

Deputy State Director for Cadastral Survey, Alaska

ALEUTIAN IS. 96-13

COPY

ORIGINAL

ALASKA NATIVE CLAIMS SETTLEMENT ACT
(ANCSA) SECTION 14(c), LOTS 1 THROUGH 42
(P.L. 92-203, 85 STAT. 688, 702, 703)
NELSON LAGOON CORPORATION
AT
NELSON LAGOON, ALASKA

REFERENCE SHOULD BE MADE
TO
SHEET NO. 1
FOR SURVEY INFORMATION

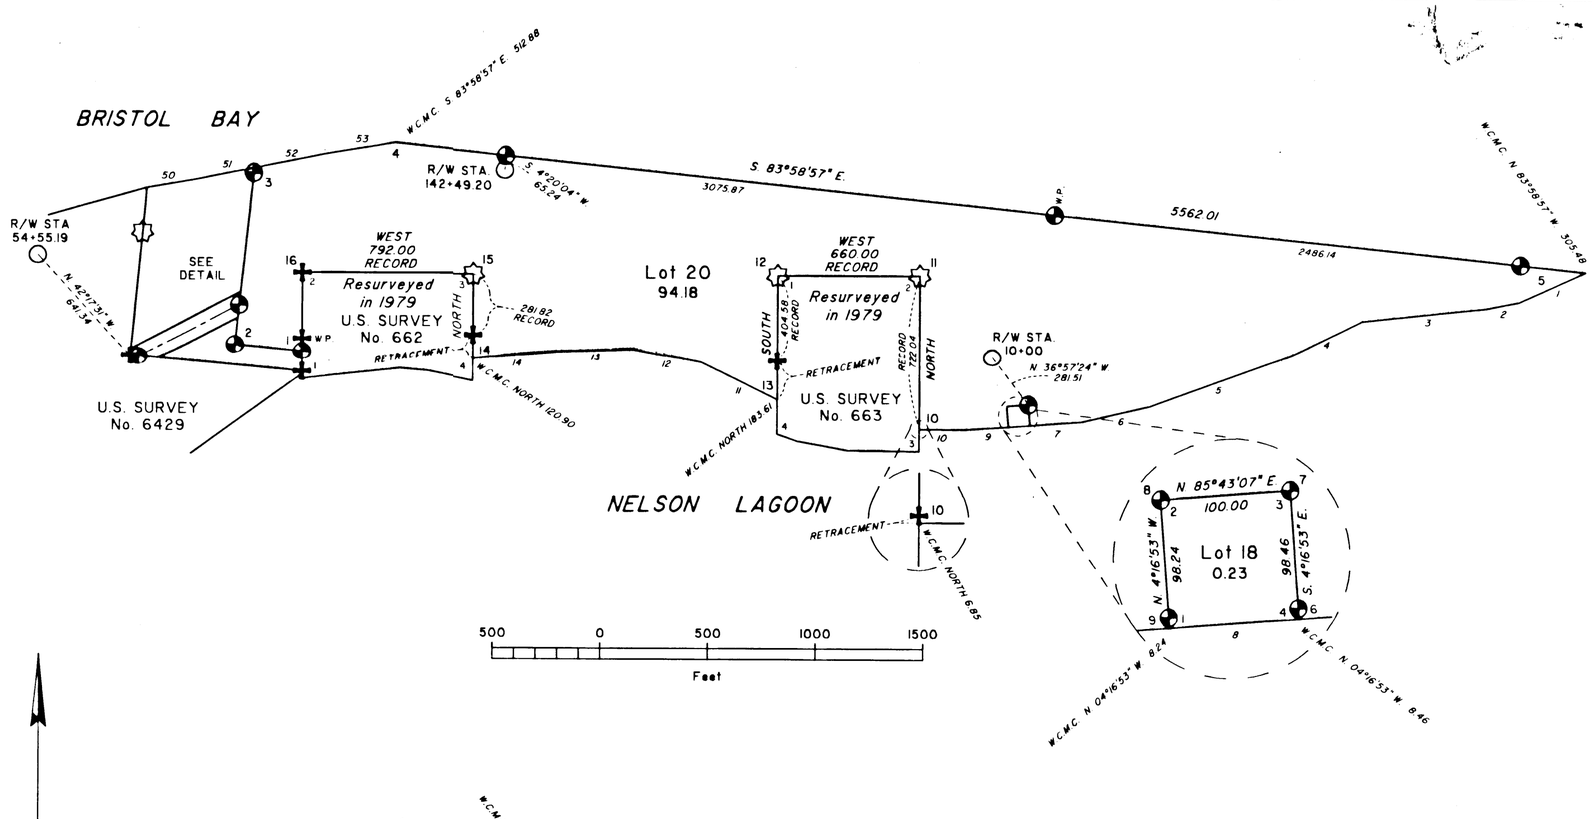

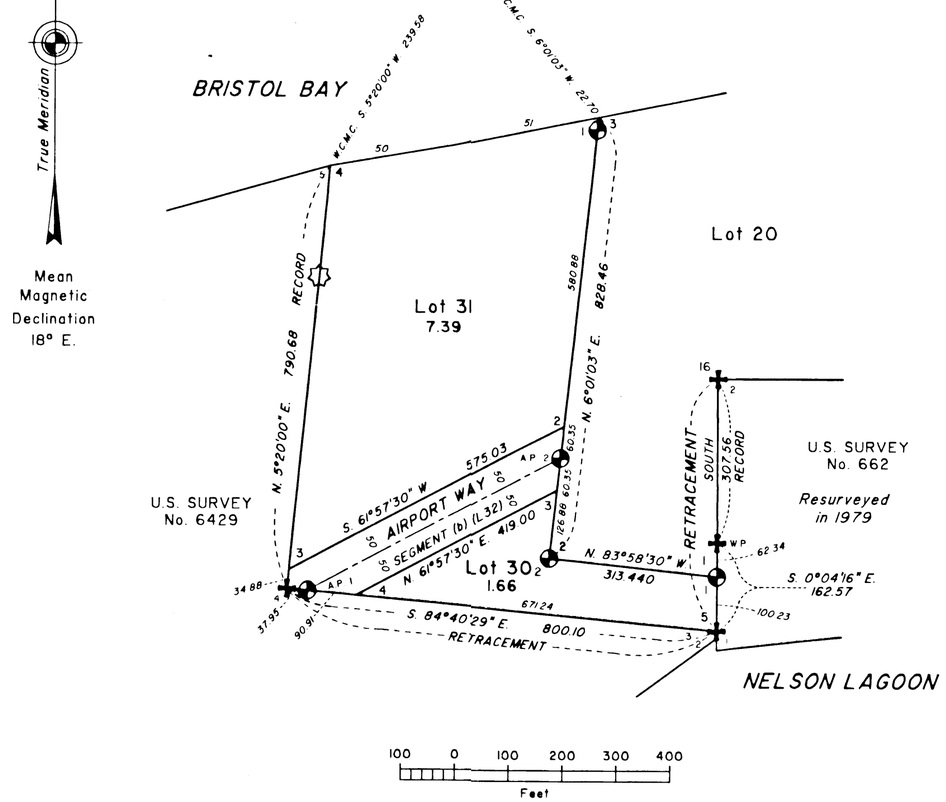

DETAIL

MEANDERS

LOT 20

1.	S. 65°43'13" W.	344.32	ft.
2.	S. 78°55'59" W.	152.70	ft.
3.	S. 83°52'24" W.	580.34	ft.
4.	S. 63°39'58" W.	424.81	ft.
5.	S. 69°47'57" W.	648.26	ft.
6.	S. 76°43'21" W.	320.30	ft.
7.	S. 85°50'44" W.	241.46	ft.

LOT 18

8.	S. 85°50'44" W.	100.00	ft.

LOT 20

9.	S. 85°50'44" W.	201.46	ft.
10.	N. 89°42'34" W.	213.73	ft.
11.	N. 63°42'07" W.	391.14	ft.
12.	N. 78°00'33" W.	321.83	ft.
13.	S. 88°14'41" W.	354.45	ft.
14.	S. 84°11'01" W.	394.88	ft.

LOT 31

50.	N. 79°41'41" E.	232.48	ft.
51.	N. 78°41'21" E.	274.77	ft.

LOT 20

52.	N. 78°41'21" E.	335.94	ft.
53.	N. 80°25'27" E.	329.96	ft.

LEGEND

- Set iron post, 2 1/2" dia., 28" long with brass cap marked ANCSA 14C, 1988 (symbol for primary monumentation used)
- Recovered B.L.M. monument
- Nonrecovered B.L.M. monument
- Recovered monument as described on the plat(s) for (i.e., name of recorded Subdivision Plat)

92-24

RECORDED - ~~FILED~~ 65 cc
ALEUTIAN IS. REC DIST.
DATE 6-16 19 92
TIME 10:30 A M
Requested by (USA/BLM)
Address

COPY

PJB/RJC

96-13
Aleutian Islands

ORIGINAL

ALASKA NATIVE CLAIMS SETTLEMENT ACT (ANCSA) SECTION 14(c), LOTS 1 THROUGH 42 (P.L. 92-203, 85 STAT. 688, 702, 703) NELSON LAGOON CORPORATION AT NELSON LAGOON, ALASKA

REFERENCE SHOULD BE MADE
TO
SHEET NO. 1
FOR SURVEY INFORMATION

LEGEND

- Set iron post, 2 1/2" dia., 28" long with brass cap marked ANCSA 14C, 1988 (symbol for primary monumentation used)
- Recovered B.L.M. monument

CURVE DATA

	Δ	R	L
1.	3°43'02"	666.19	45.29
2.	3°43'02"	716.19	46.47
3.	3°43'02"	766.19	47.64
4.	10°53'30"	904.95	172.03
5.	10°53'30"	954.95	181.53
6.	10°53'30"	1004.95	191.04
7.	71°50'13"	188.73	236.63
8.	32°59'48"	188.73	108.69
9.	81°35'20"	238.73	339.95
10.	23°14'42"	238.73	96.85
11.	75°56'10"	288.73	382.66
12.	19°54'55"	288.73	100.36

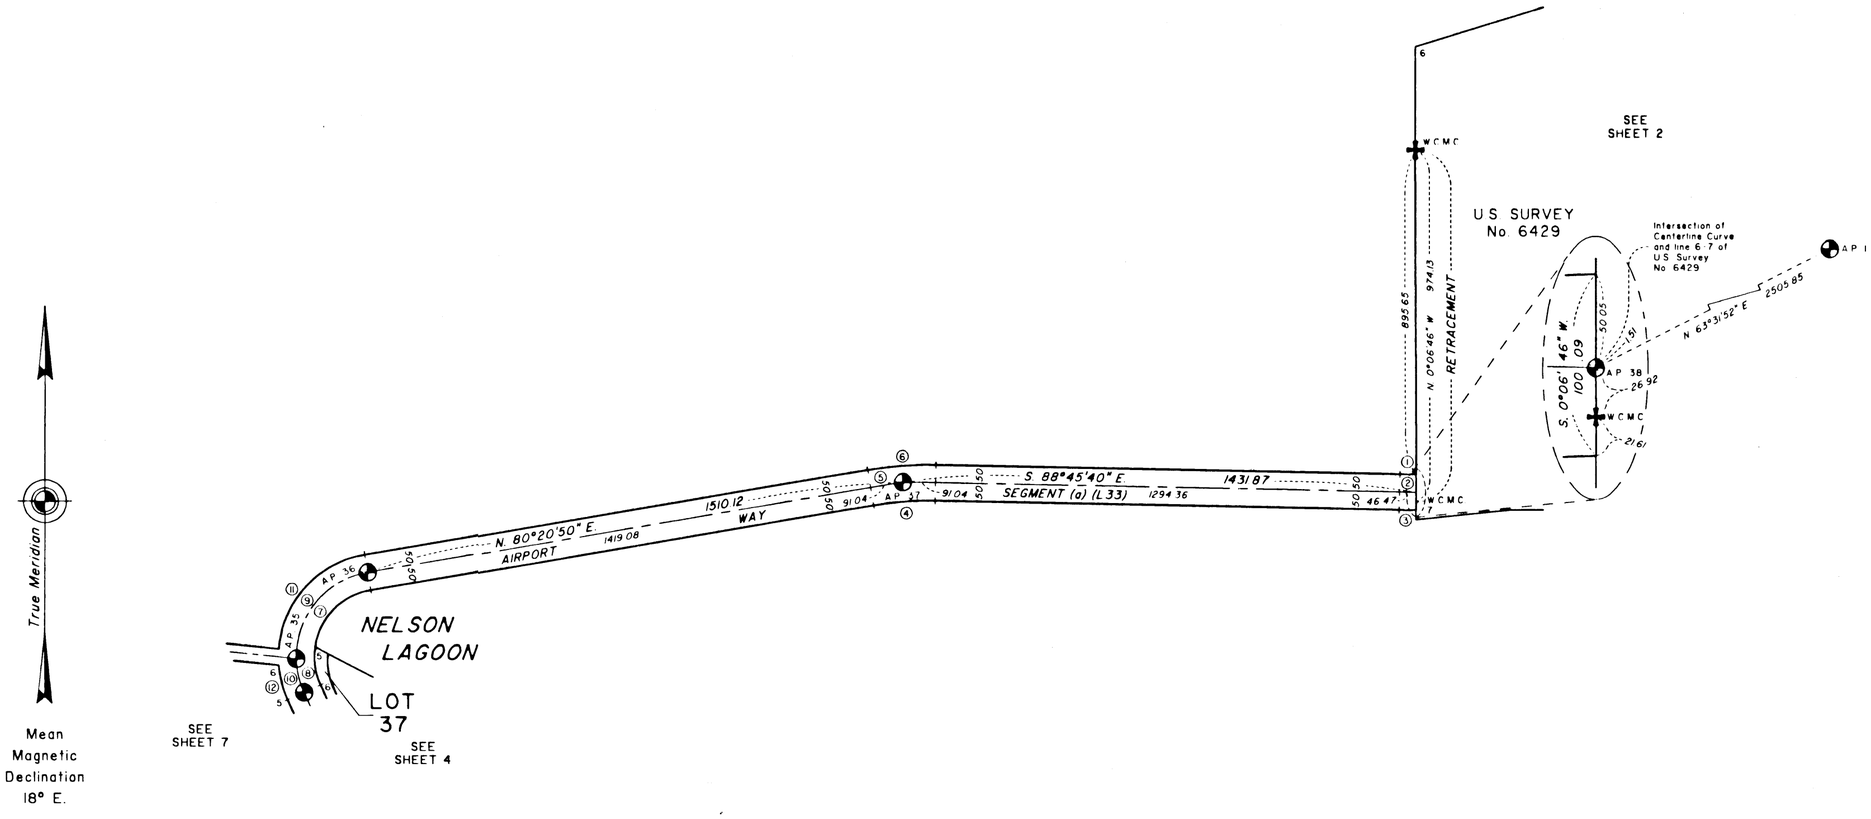

AMENDMENT NOTE:

The bearing noted in the bubble detail of U.S. Survey No. 6429 as S. 0°06'46" W., is now corrected to read S. 0°06'46" E.

92-24
RECORDED - ~~FILED~~ 65 cc
ALEUTIAN IS REC DIST
DATE 6-16 1992
TIME 10:30 AM
REQUESTED BY (USA/BLM)
ADDRESS

COPY

RJC

96-13
Aleutian Islands

LEGEND

- Set iron post, 2 1/2" dia., 28" long with brass cap marked ANCSA 14C, 1988. (symbol for primary monumentation used)
- Set 5/8" rebar, with 2" aluminum cap marked ANCSA 14C, 1988. (symbol for secondary monumentation used)
- Recovered monument as described on the plat(s) for... (i.e., name of recorded Subdivision Plat).
- —U— Centerline for utility easement, 10 ft wide.
- (DIST.) Distance to utility line
- ANGLE POINT (symbol for no monument set)

CURVE DATA

	Δ	R	L
7.	71°50'13"	188.73	236.63
8.	32°59'48"	188.73	108.69
9.	81°35'20"	238.73	339.95
10.	23°14'42"	238.73	96.85
11.	75°56'10"	288.73	382.66
12.	19°54'55"	288.73	100.36
13.	14°07'23"	188.73	46.52
14.	16°05'07"	188.73	52.98

MEANDERS

LOT 37

15. S 62°10'03" E. 40.00 ft.

LOT 21

16. S 62°10'03" E. 164.28 ft.
17. N 87°04'00" E. 182.38 ft.
18. S 79°04'19" E. 76.61 ft.

LOT 43

19. S 79°04'19" E. 16.51 ft.
20. S 56°10'55" E. 83.96 ft.
21. S 45°07'09" E. 33.45 ft.
22. S 35°44'00" E. 348.46 ft.
23. S 8°27'26" E. 145.85 ft.
24. S 32°55'54" E. 122.05 ft.

LOT 33

25. S 32°55'54" E. 57.53 ft.

UTILITY DATA

LINE K

1. N 14°57'01" E. 198.94 (LOT B - 0.05 AC.)

ALASKA NATIVE CLAIMS SETTLEMENT ACT (ANCSA) SECTION 14(c), LOTS 1 THROUGH 42 (P.L. 92-203, 85 STAT. 688, 702, 703) NELSON LAGOON CORPORATION AT NELSON LAGOON, ALASKA

REFERENCE SHOULD BE MADE TO SHEET NO. 1 FOR SURVEY INFORMATION

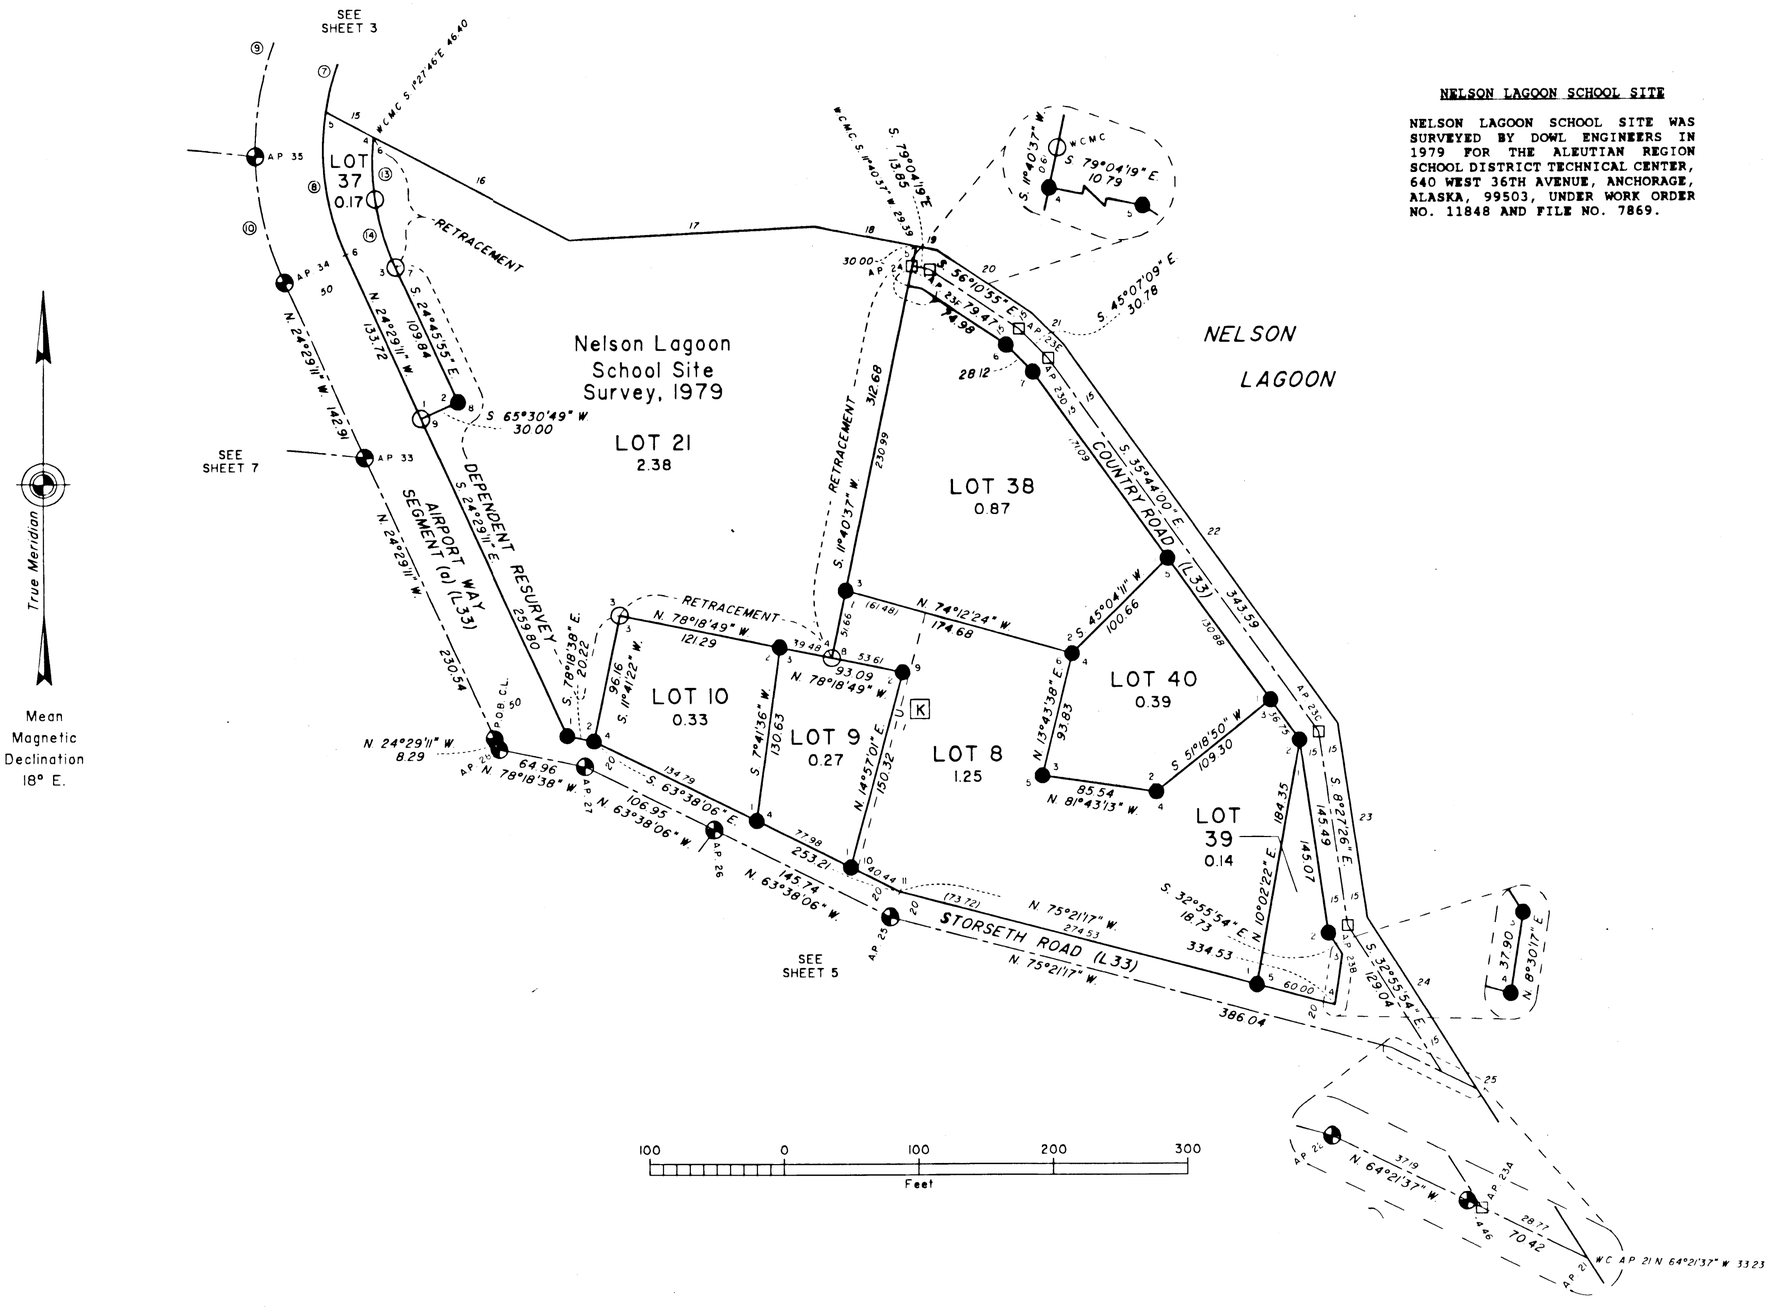

NELSON LAGOON SCHOOL SITE

NELSON LAGOON SCHOOL SITE WAS SURVEYED BY DOWL ENGINEERS IN 1979 FOR THE ALEUTIAN REGION SCHOOL DISTRICT TECHNICAL CENTER, 640 WEST 36TH AVENUE, ANCHORAGE, ALASKA, 99503, UNDER WORK ORDER NO. 11848 AND FILE NO. 7869.

COPY

92-24

RECORDED ~~FILED~~ 65 cc
ALEUTIAN IS REC DIST
DATE 4-16 19 92
TIME 10:30 A M
Requested by
Address (USA/BLM)

RJC

96-13
Aleutian Islands

ORIGINAL

ALASKA NATIVE CLAIMS SETTLEMENT ACT (ANCSA) SECTION 14(c), LOTS 1 THROUGH 42 (P.L. 92-203, 85 STAT. 688, 702, 703) NELSON LAGOON CORPORATION AT NELSON LAGOON, ALASKA

REFERENCE SHOULD BE MADE
TO
SHEET NO. 1
FOR SURVEY INFORMATION

LEGEND

- Set iron post, 2 1/2" dia., 28" long with brass cap marked ANCSA 14C, 1988. (symbol for primary monumentation used)
- Set 5/8" rebar, with 2" aluminum cap marked ANCSA 14C, 1988. (symbol for secondary monumentation used)
- —U— Centerline for utility easement, 10 ft. wide
- (DIST.) Distance to utility line

MEANDERS

	LOT 33		
25.	S. 32°55'54" E.	57.53	ft.
	LOT 34		
26.	S. 32°55'54" E.	25.56	ft.
27.	S. 59°15'34" W.	147.41	ft.
	LOT 7		
28.	S. 59°15'34" W.	24.85	ft.
29.	S. 76°02'23" W.	41.94	ft.
	LOT 33		
30.	S. 76°02'23" W.	50.75	ft.
	LOT 11		
31.	S. 76°02'23" W.	355.16	ft.
	LOT 33		
32.	S. 76°02'23" W.	30.80	ft.
	LOT 12		
33.	S. 76°02'23" W.	113.27	ft.
	LOT 28		
34.	S. 76°02'23" W.	107.34	ft.

UTILITY DATA

LINE F

1.	N. 6°57'27" E.	14.67	(INCLUDED IN LINE "G" LOT 12)
2.	N. 6°57'27" E.	23.16	(LOT 5 - 0.005 AC.)

LINE G

8.	S. 89°14'03" E.	13.85	(LOT 28 - 0.003 AC.)
9.	S. 89°14'03" E.	79.73	(INCLUDED IN LINE 10)
10.	S. 89°14'03" E.	109.16	(LOT 5 - 0.005 AC.)(LOT 12 - 0.04 AC)
11.	N. 64°12'21" E.	41.06	(LOT 6 - 0.007 AC.)
12.	N. 64°12'21" E.	41.06	(INCLUDED IN LINE "L" LOT 7)
13.	N. 6°03'51" E.	85.22	

LINE L

1.	S. 3°55'39" E.	60.11	(LOT 7 - 0.04 AC.)

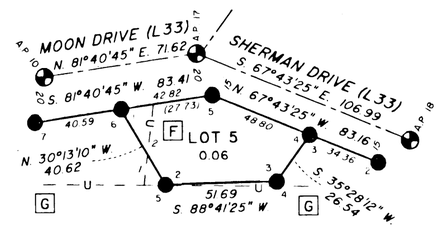

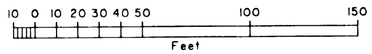

Detail

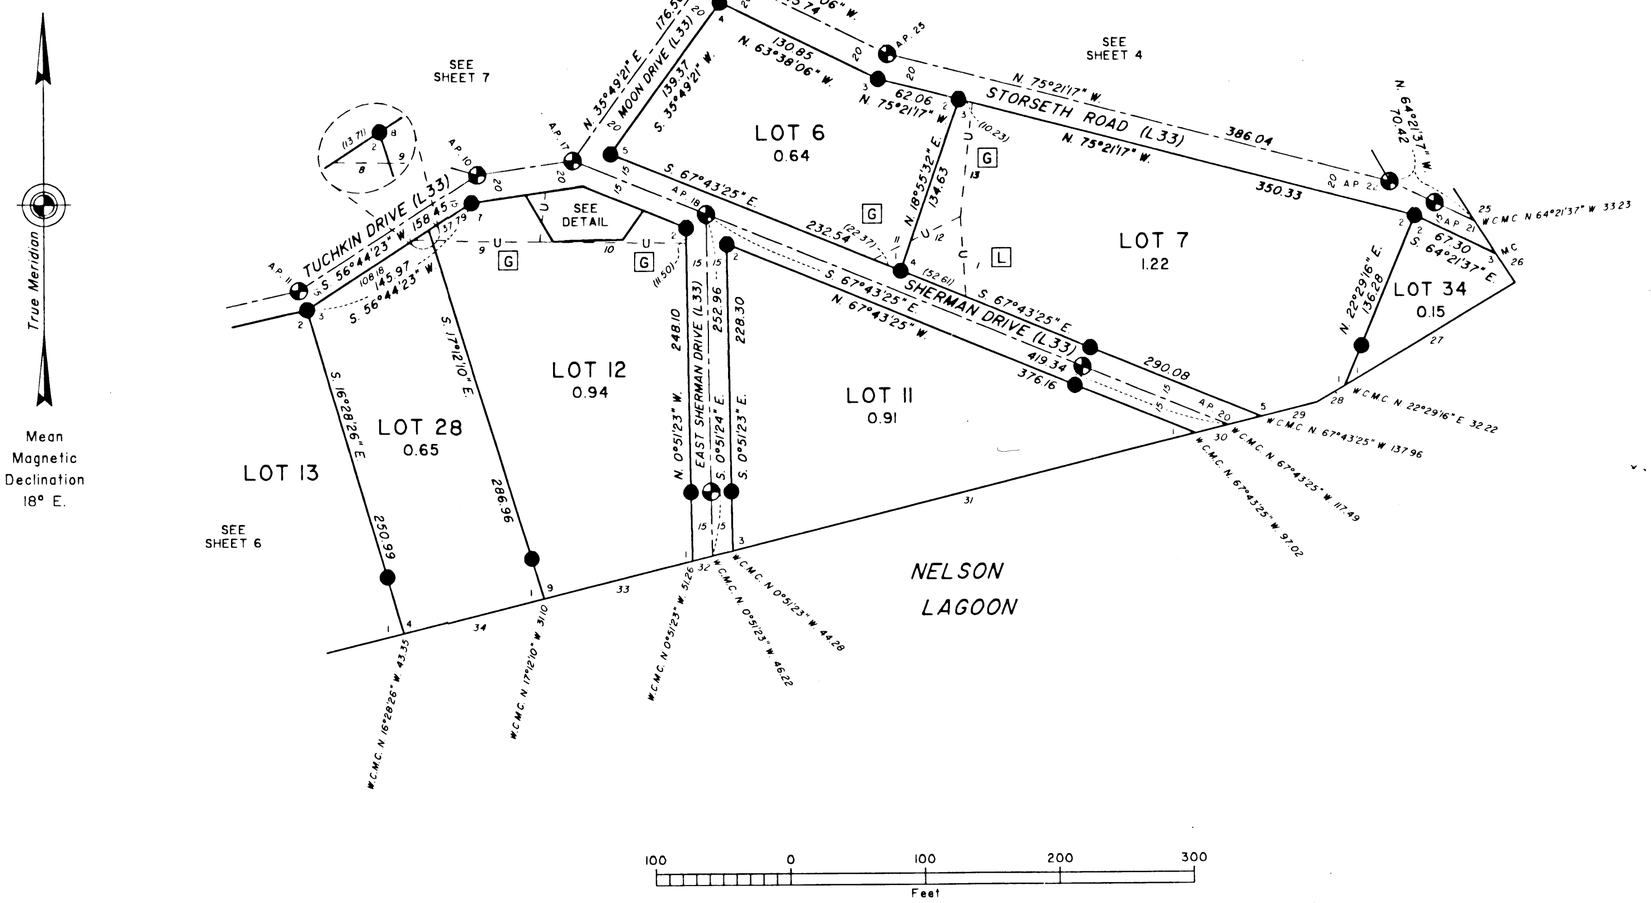

COPY

92-24

RECORDED - ~~FILED~~ 65 cc
NELSON IS REC. DIST.
DATE 6-16 19 92
TIME 10:30 A.M.
Requested by (USA/ACM)
Address

RJC

96-13
Aleutian Islands

ORIGINAL

ALASKA NATIVE CLAIMS SETTLEMENT ACT (ANCSA) SECTION 14(c), LOTS 1 THROUGH 42 (P.L. 92-203, 85 STAT. 688, 702, 703) NELSON LAGOON CORPORATION AT NELSON LAGOON, ALASKA

REFERENCE SHOULD BE MADE
TO
SHEET NO. 1
FOR SURVEY INFORMATION

LEGEND

- Set iron post, 2 1/2" dia., 28" long with brass cap marked ANCSA 14C, 1988 (symbol for primary monumentation used)
- Set 5/8" rebar, with 2" aluminum cap marked ANCSA 14C, 1988 (symbol for secondary monumentation used)

MEANDERS

LOT 13

35. S. 76°02'23" W. 244.33 ft.
36. S. 68°15'05" W. 53.45 ft.

LOT 15

37. S. 68°15'05" W. 232.33 ft.

LOT 16

38. S. 68°15'05" W. 29.81 ft.

LOT 17

39. S. 68°15'05" W. 29.86 ft.

LOT 14

40. S. 68°15'05" W. 87.23 ft.

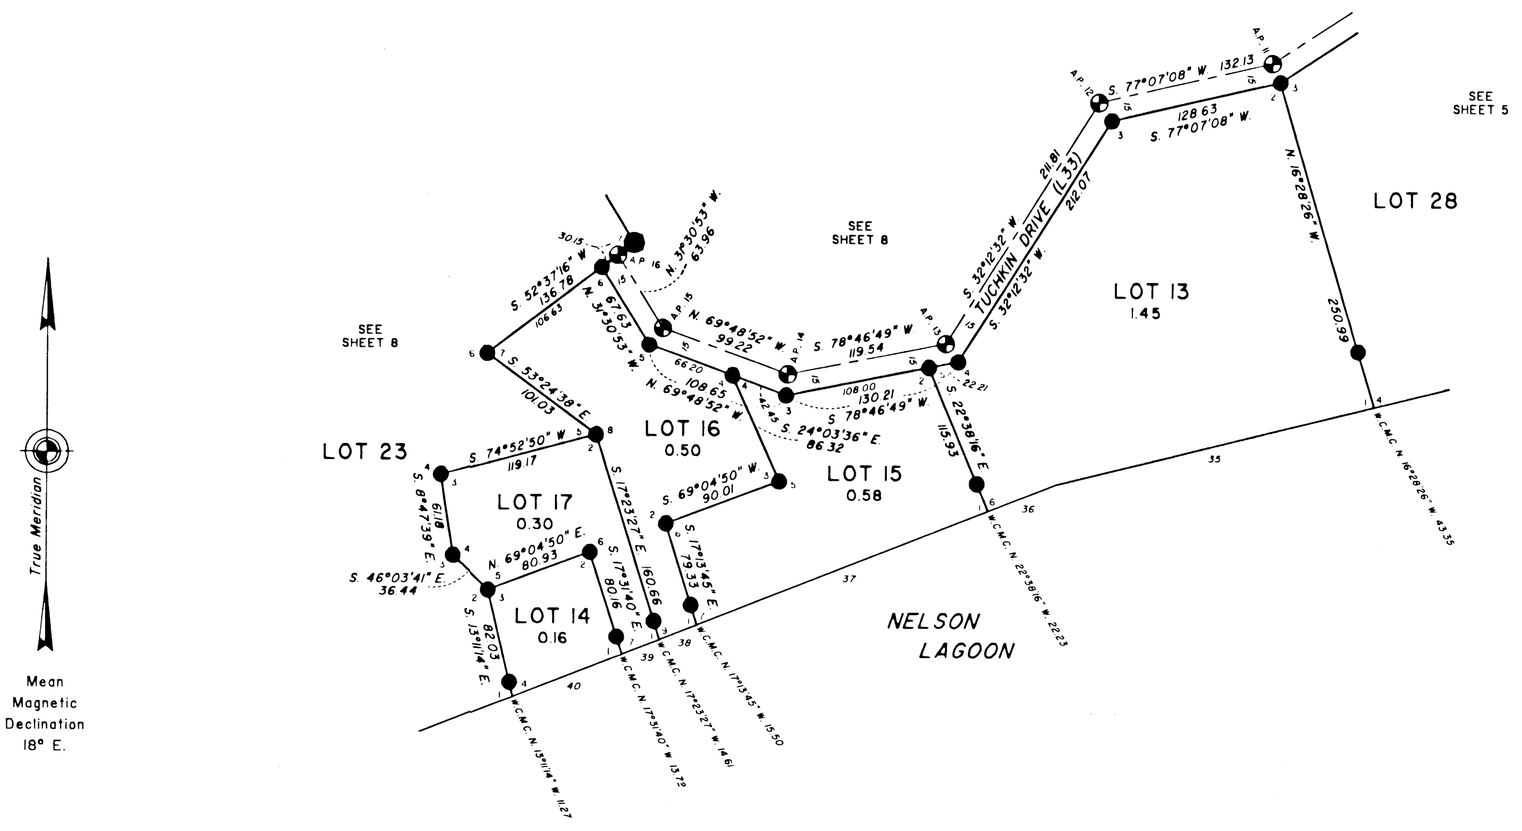

COPY

92-24

RECORDED ~~FILED~~ 65 cc
ALEUTIAN IS REC DIST
DATE 6-16 19 92
TIME 10:30 A M
Requested by (USA/BLM)
Address

RJC

96-13
Aleutian Islands

ORIGINAL

ALASKA NATIVE CLAIMS SETTLEMENT ACT (ANCSA) SECTION 14(c), LOTS 1 THROUGH 42 (P.L. 92-203, 85 STAT. 688, 702, 703) NELSON LAGOON CORPORATION AT NELSON LAGOON, ALASKA

REFERENCE SHOULD BE MADE
TO
SHEET NO. 1
FOR SURVEY INFORMATION

MEANDERS

LOT 33

49. N. 70°00'00" E. 45.95 ft.

CURVE DATA

	Δ	R	L
10.	23°14'42"	238.73	96.85
12.	19°54'55"	288.73	100.36
15.	40°22'03"	17.50	12.33
16.	260°44'07"	35.00	159.27
17.	40°22'03"	17.50	12.33
18.	180°00'00"	196.34	616.84
19.	53°34'18"	216.34	202.28
20.	10°01'02"	216.34	37.82
21.	23°25'48"	216.34	88.47
22.	43°54'45"	216.34	165.81
23.	4°41'32"	216.34	17.71
24.	14°03'07"	196.34	48.15
25.	68°01'54"	196.34	233.13
26.	20°21'09"	196.34	69.74
27.	77°33'50"	196.34	265.80
28.	86°09'53"	176.34	265.20
29.	37°19'29"	176.34	114.88
30.	24°10'16"	176.34	74.39
31.	32°20'22"	176.34	99.53
32.	8°58'56"	288.73	45.26

UTILITY DATA

LINE A

1. S. 85°00'28" E. 285.09

LINE B

1. S. 60°37'52" E. 59.81 ┐ (LOT 36 - 0.02 AC.)
2. S. 79°08'42" E. 42.20 ┘
3. S. 68°54'46" E. 60.14 — (LOT 25 - 0.10 AC.)
4. S. 68°54'46" E. 4.41 ┐
5. S. 86°21'53" E. 112.06 │ (LOT 1 - 0.05 AC.)
6. S. 43°47'28" E. 31.32 │
7. S. 14°10'25" E. 47.15 ┘

LINE C

1. S. 77°58'13" W. 10.15 ┐
2. S. 86°51'10" W. 86.18 │ (LOT 41 - 0.05 AC.)
3. S. 74°15'01" W. 53.90 │
4. S. 80°40'11" W. 55.46 ┘
5. S. 80°40'11" W. 12.05 ┐ (LOT 22 - 0.02 AC.)
6. N. 81°18'27" W. 56.80 ┘
7. N. 81°18'27" E. 2.33 ┐
8. N. 77°11'05" W. 60.64 │
9. N. 83°28'08" W. 65.94 │ (LOT 2 - 0.06 AC.)
10. N. 82°38'38" E. 58.05 │
11. N. 84°12'00" W. 50.20 ┘
12. N. 84°12'00" W. 21.78 ┐
13. N. 81°18'51" W. 103.71 │
14. N. 81°33'54" W. 55.35 │ (LOT 41 - 0.07 AC.)
15. N. 89°36'29" W. 21.06 │
16. S. 89°44'01" W. 38.41 │
17. S. 37°25'21" W. 3.74 ┘
18. S. 37°25'21" W. 23.86 — (LOT 1 - 0.005 AC.)

LINE D

1. N. 9°40'25" E. 20.33 ┐
2. N. 14°54'12" E. 149.48 ┘ (LOT 1 - 0.04 AC.)
3. N. 54°14'34" E. 4.60 ┐
4. N. 54°14'34" E. 58.47 — (INCLUED IN LINE "C" LOT 2)

LINE E

1. N. 38°03'33" W. 26.24 ┐ (INCLUED IN LINE "C" LOT 41)
2. N. 26°58'14" W. 47.89 ┘

LINE F

3. N. 6°57'27" E. 40.83 ┐ (LOT 4 - 0.02 AC.)
4. N. 84°53'33" E. 29.69 ┘

LINE M

1. N. 80°23'37" W. 136.19 ┐ (LOT 3 - 0.06 AC.)
2. S. 6°02'03" E. 138.29 ┘

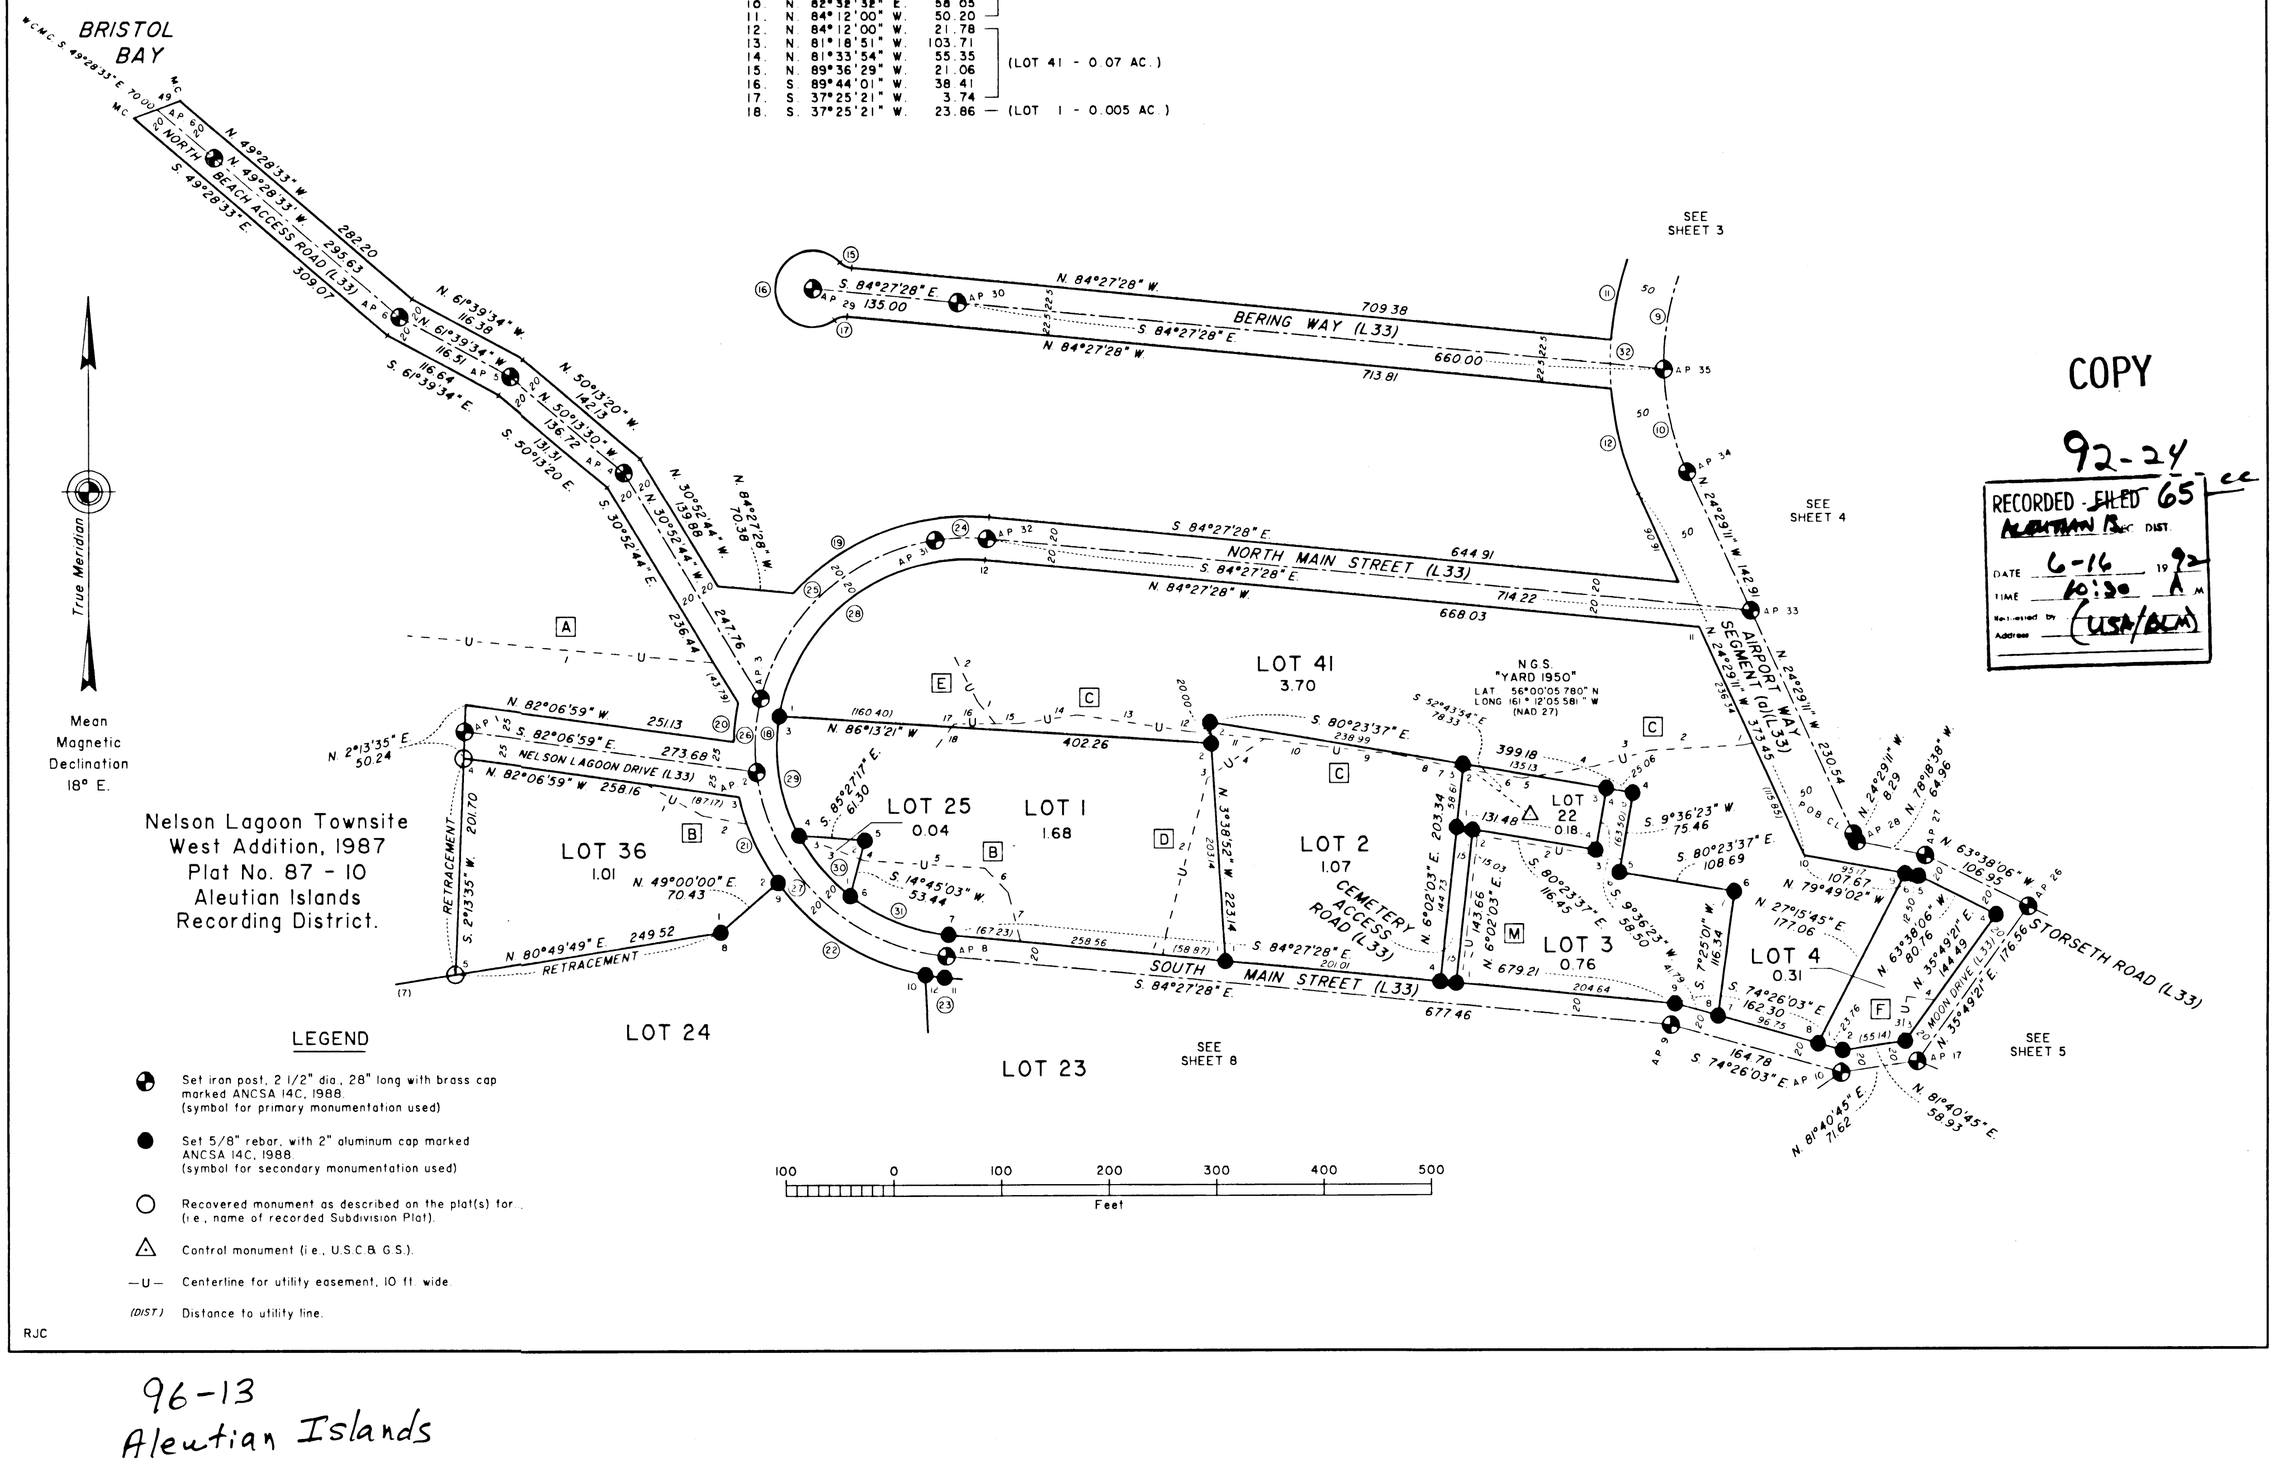

LEGEND

- Set iron post, 2 1/2" dia., 28" long with brass cap marked ANCSA 14C, 1988. (symbol for primary monumentation used)
- Set 5/8" rebar, with 2" aluminum cap marked ANCSA 14C, 1988. (symbol for secondary monumentation used)
- ○ Recovered monument as described on the plat(s) for.. (i.e., name of recorded Subdivision Plat).
- △ Control monument (i.e., U.S.C.& G.S.).
- —U— Centerline for utility easement, 10 ft. wide
- (DIST.) Distance to utility line.

RJC

COPY

92-24

RECORDED - FILED 65
ALEUTIAN DIST. REC. DIST.
DATE 6-16 19 92
TIME 10:30 A M
Returned by (USA/BLM)
Address

96-13
Aleutian Islands

ALASKA NATIVE CLAIMS SETTLEMENT ACT (ANCSA) SECTION 14(c), LOTS 1 THROUGH 42 (P.L. 92-203, 85 STAT. 688, 702, 703) NELSON LAGOON CORPORATION AT NELSON LAGOON, ALASKA

REFERENCE SHOULD BE MADE
TO
SHEET NO. 1
FOR SURVEY INFORMATION

LEGEND

- Set iron post, 2 1/2" dia., 28" long with brass cap marked ANCSA 14C, 1988 (symbol for primary monumentation used)
- Set 5/8" rebar, with 2" aluminum cap marked ANCSA 14C, 1988 (symbol for secondary monumentation used)
- Recovered monument as described on the plat(s) for .. (i.e., name of recorded Subdivision Plat).
- —U— Centerline for utility easement, 10 ft. wide.
- (DIST.) Distance to utility line

MEANDERS

LOT 23

41.	S. 68°15'05" W.	248.88 ft.
42.	S. 74°39'18" W.	116.99 ft.

LOT 29

43.	S. 74°39'18" W.	210.23 ft.
44.	N. 82°06'15" W.	32.43 ft.

CURVE DATA

	Δ	R	L
23.	4°41'32"	216.34	17.71

UTILITY DATA

LINE G

1.	S 58°11'03" E.	26.79
2.	N 48°02'03" E.	41.18
3.	N 86°56'03" E.	61.33
4.	N 59°08'04" E.	190.99
5.	S 69°17'27" E.	30.43
6.	S 69°17'27" E.	59.53
7.	S 89°14'03" E.	41.18

LINE H

1.	S 28°18'27" E.	161.06
2.	S 28°18'27" E.	30.98

(LOT 35 - 0.16 AC.)

LINE I

1.	N 63°07'33" E.	104.73

LINE J

1.	N 2°16'00" E.	62.05

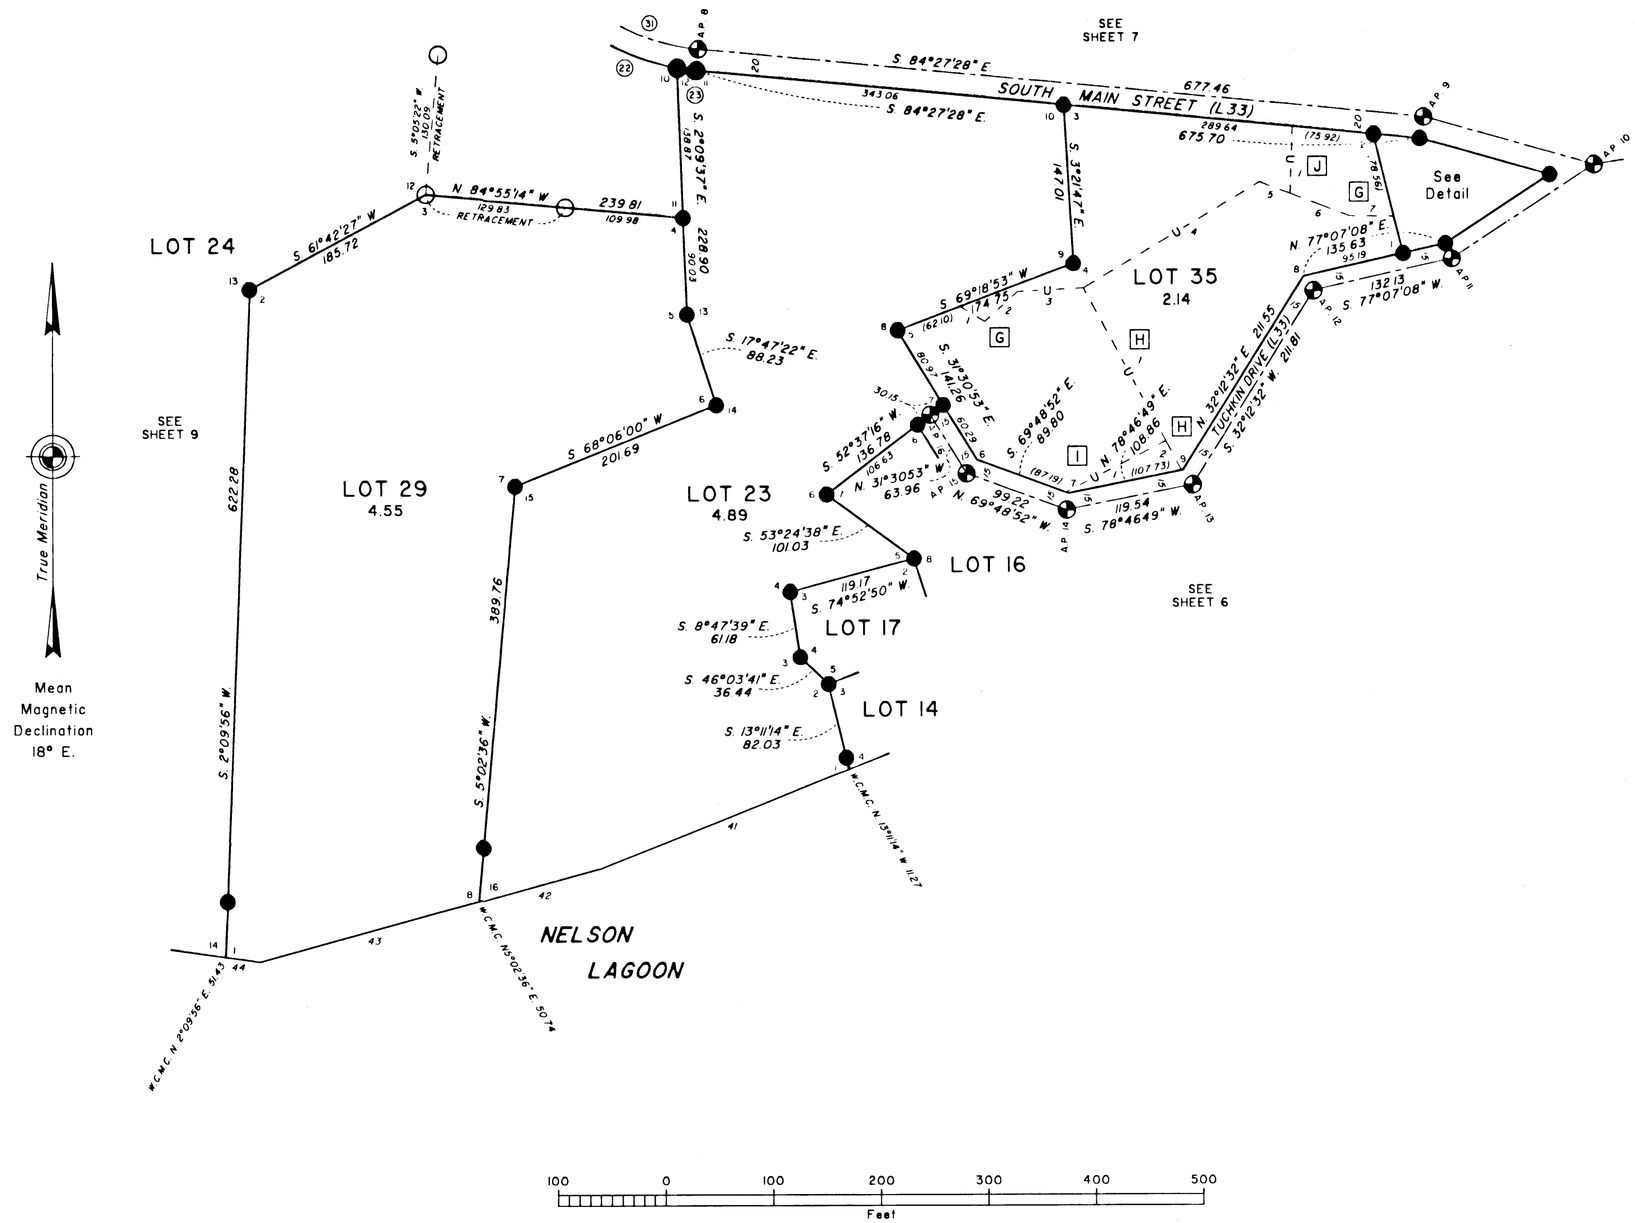

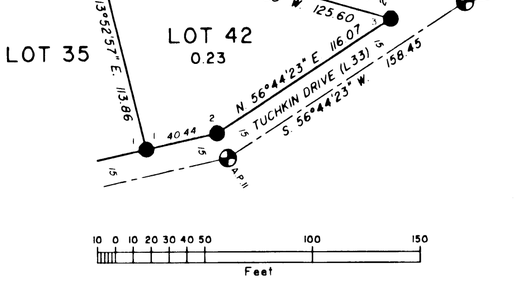

Detail

COPY

92-24

RECORDED - ~~FILED~~ 65 cc
ALEUTIAN IS REC DIST
DATE 6-16 19 92
TIME 10:30 AM
Returned by
Address (USA/BLM)

RJC

96-13
Aleutian Islands

ORIGINAL

ALASKA NATIVE CLAIMS SETTLEMENT ACT (ANCSA) SECTION 14(c), LOTS 1 THROUGH 42 (P.L. 92-203, 85 STAT. 688, 702, 703) NELSON LAGOON CORPORATION AT NELSON LAGOON, ALASKA

REFERENCE SHOULD BE MADE TO SHEET NO. 1 FOR SURVEY INFORMATION

LEGEND

- Set iron post, 2 1/2" dia., 28" long with brass cap marked ANCSA 14C, 1988 (symbol for primary monumentation used)
- Set 5/8" rebar, with 2" aluminum cap marked ANCSA 14C, 1988 (symbol for secondary monumentation used)
- Recovered monument as described on the plat(s) for... (i.e., name of recorded Subdivision Plat).

CURVE DATA

	Δ	R	L
22	43°54'45"	216.34	165.81
33	3°49'38"	244.40	16.33
34	30°35'57"	194.10	103.66
35	30°35'57"	194.10	103.66
36	61°11'55"	169.10	180.61

Nelson Lagoon Townsite
West Addition, 1987
Plat No. 87 - 10
Aleutian Islands
Recording District.

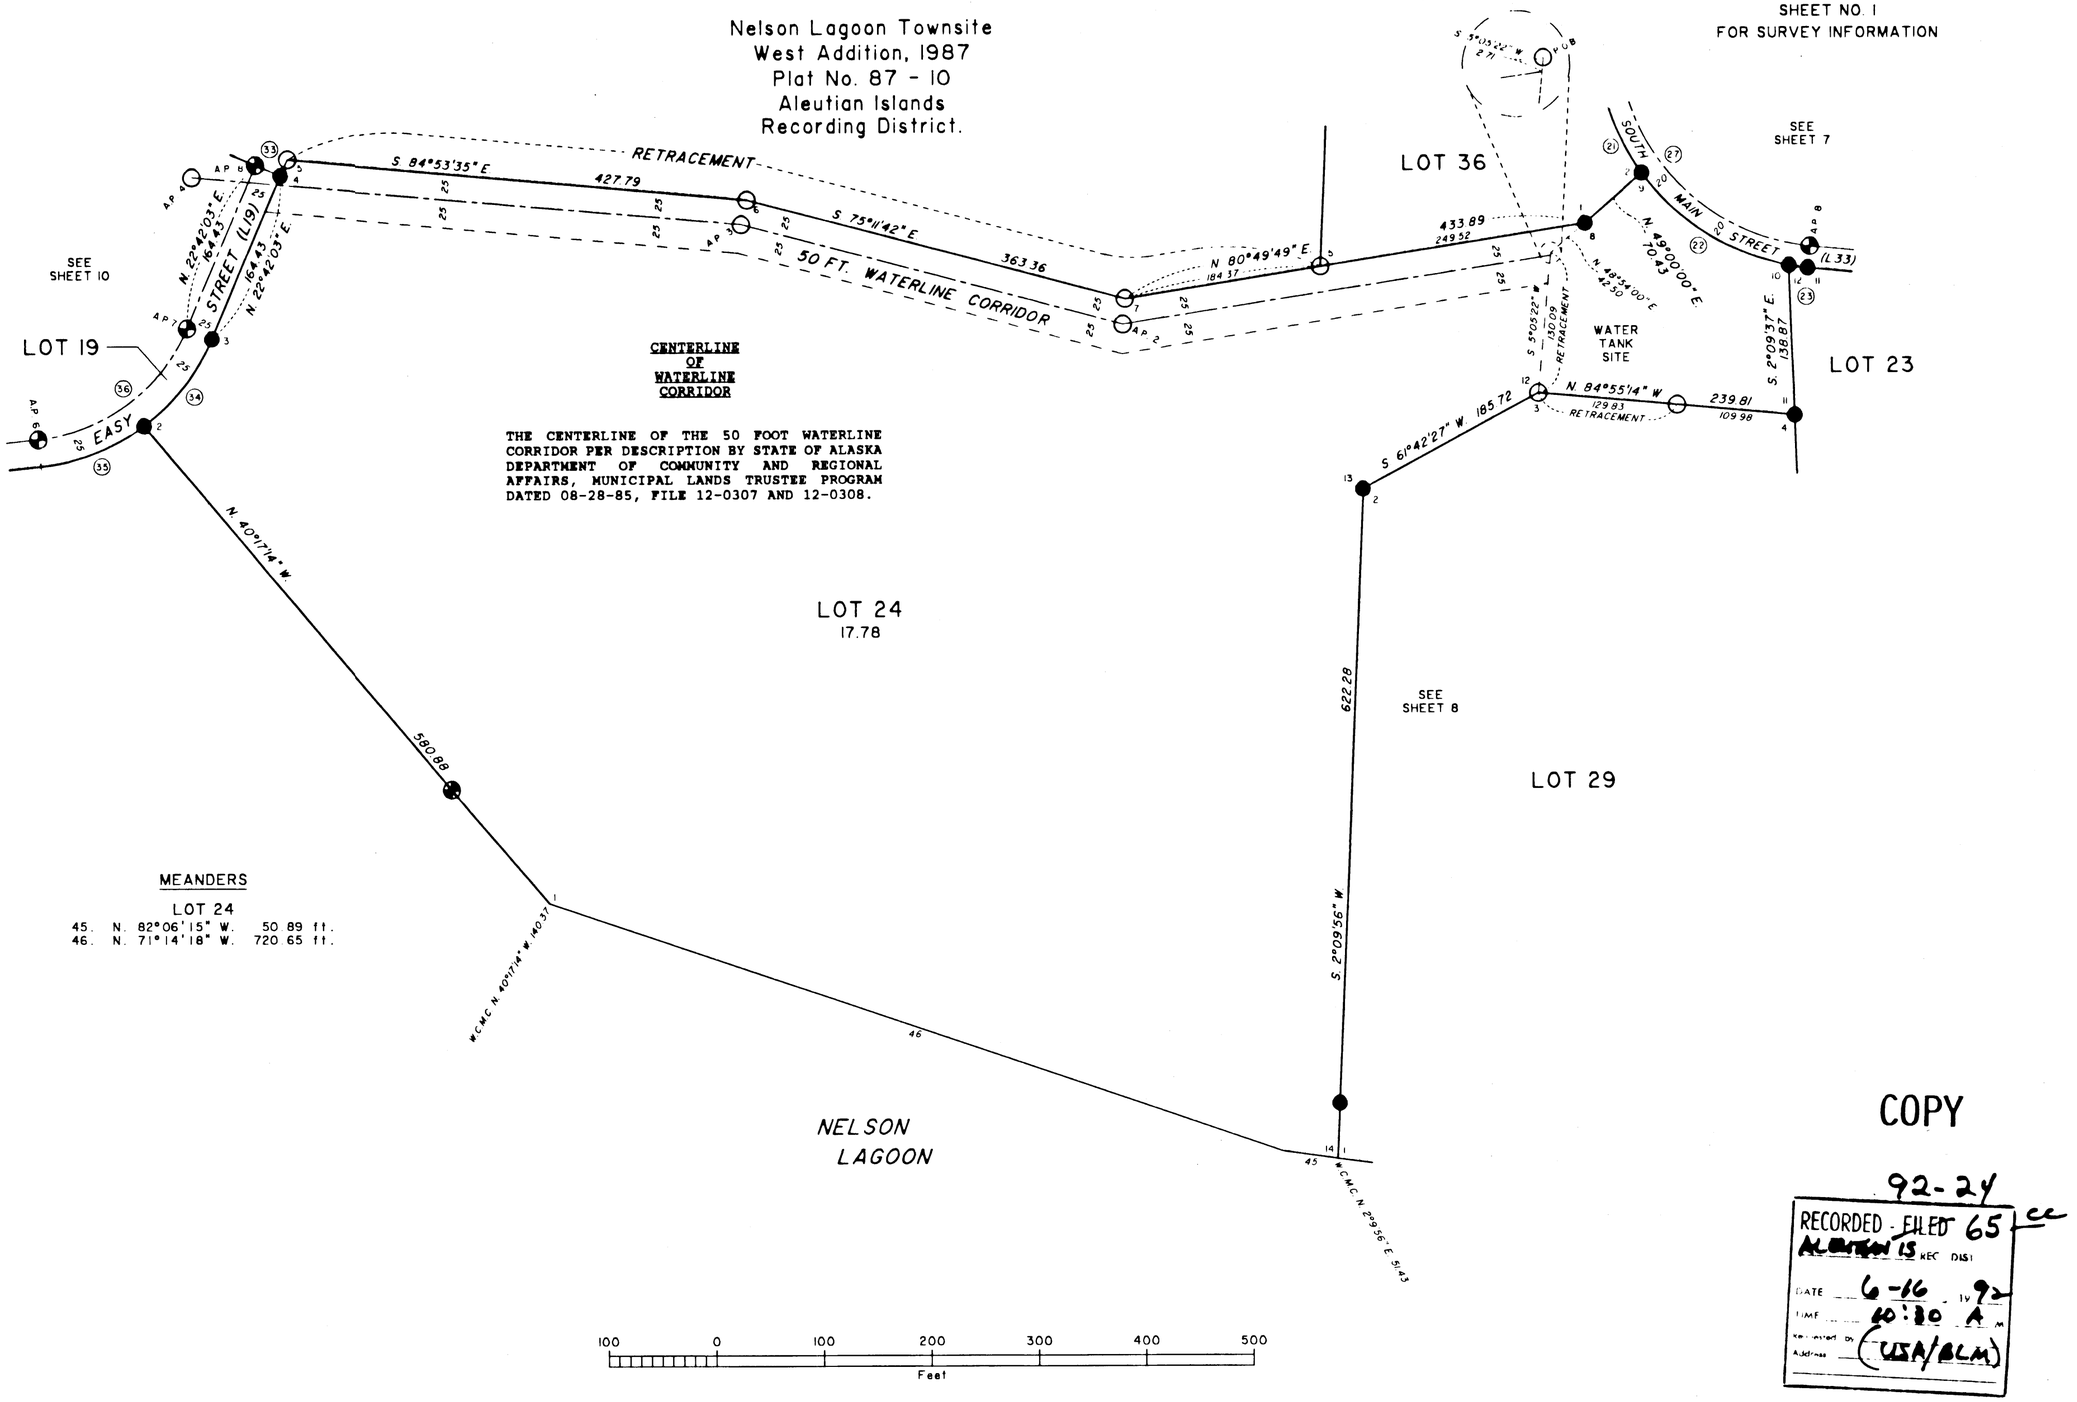

MEANDERS

LOT 24

45. N. 82°06'15" W. 50.89 ft.
46. N. 71°14'18" W. 720.65 ft.

COPY

92-24

RECORDED - FILED 65 cc
ALEUTIAN IS REC DIST
DATE 6-16 19 92
TIME 10:30 AM
Requested by (USA/BLM)
Address

RJC

96-13
Aleutian Islands

ORIGINAL

Sheet 10 of 10

ALASKA NATIVE CLAIMS SETTLEMENT ACT (ANCSA) SECTION 14(c), LOTS 1 THROUGH 42 (P.L. 92-203, 85 STAT. 688, 702, 703) NELSON LAGOON CORPORATION AT NELSON LAGOON, ALASKA

REFERENCE SHOULD BE MADE TO SHEET NO. 1 FOR SURVEY INFORMATION

LEGEND

- Set iron post, 2 1/2" dia., 28" long with brass cap marked ANCSA 14C, 1988 (symbol for primary monumentation used)
- Set 5/8" rebar, with 2" aluminum cap marked ANCSA 14C, 1988 (symbol for secondary monumentation used)
- Recoverd monument as described on the plat(s) for.. (i.e., name of recorded Subdivision Plat).

MEANDERS

LOT 26

47. N. 65°20'47" E. 99.01 ft.
48. N. 60°13'53" E. 190.15 ft.

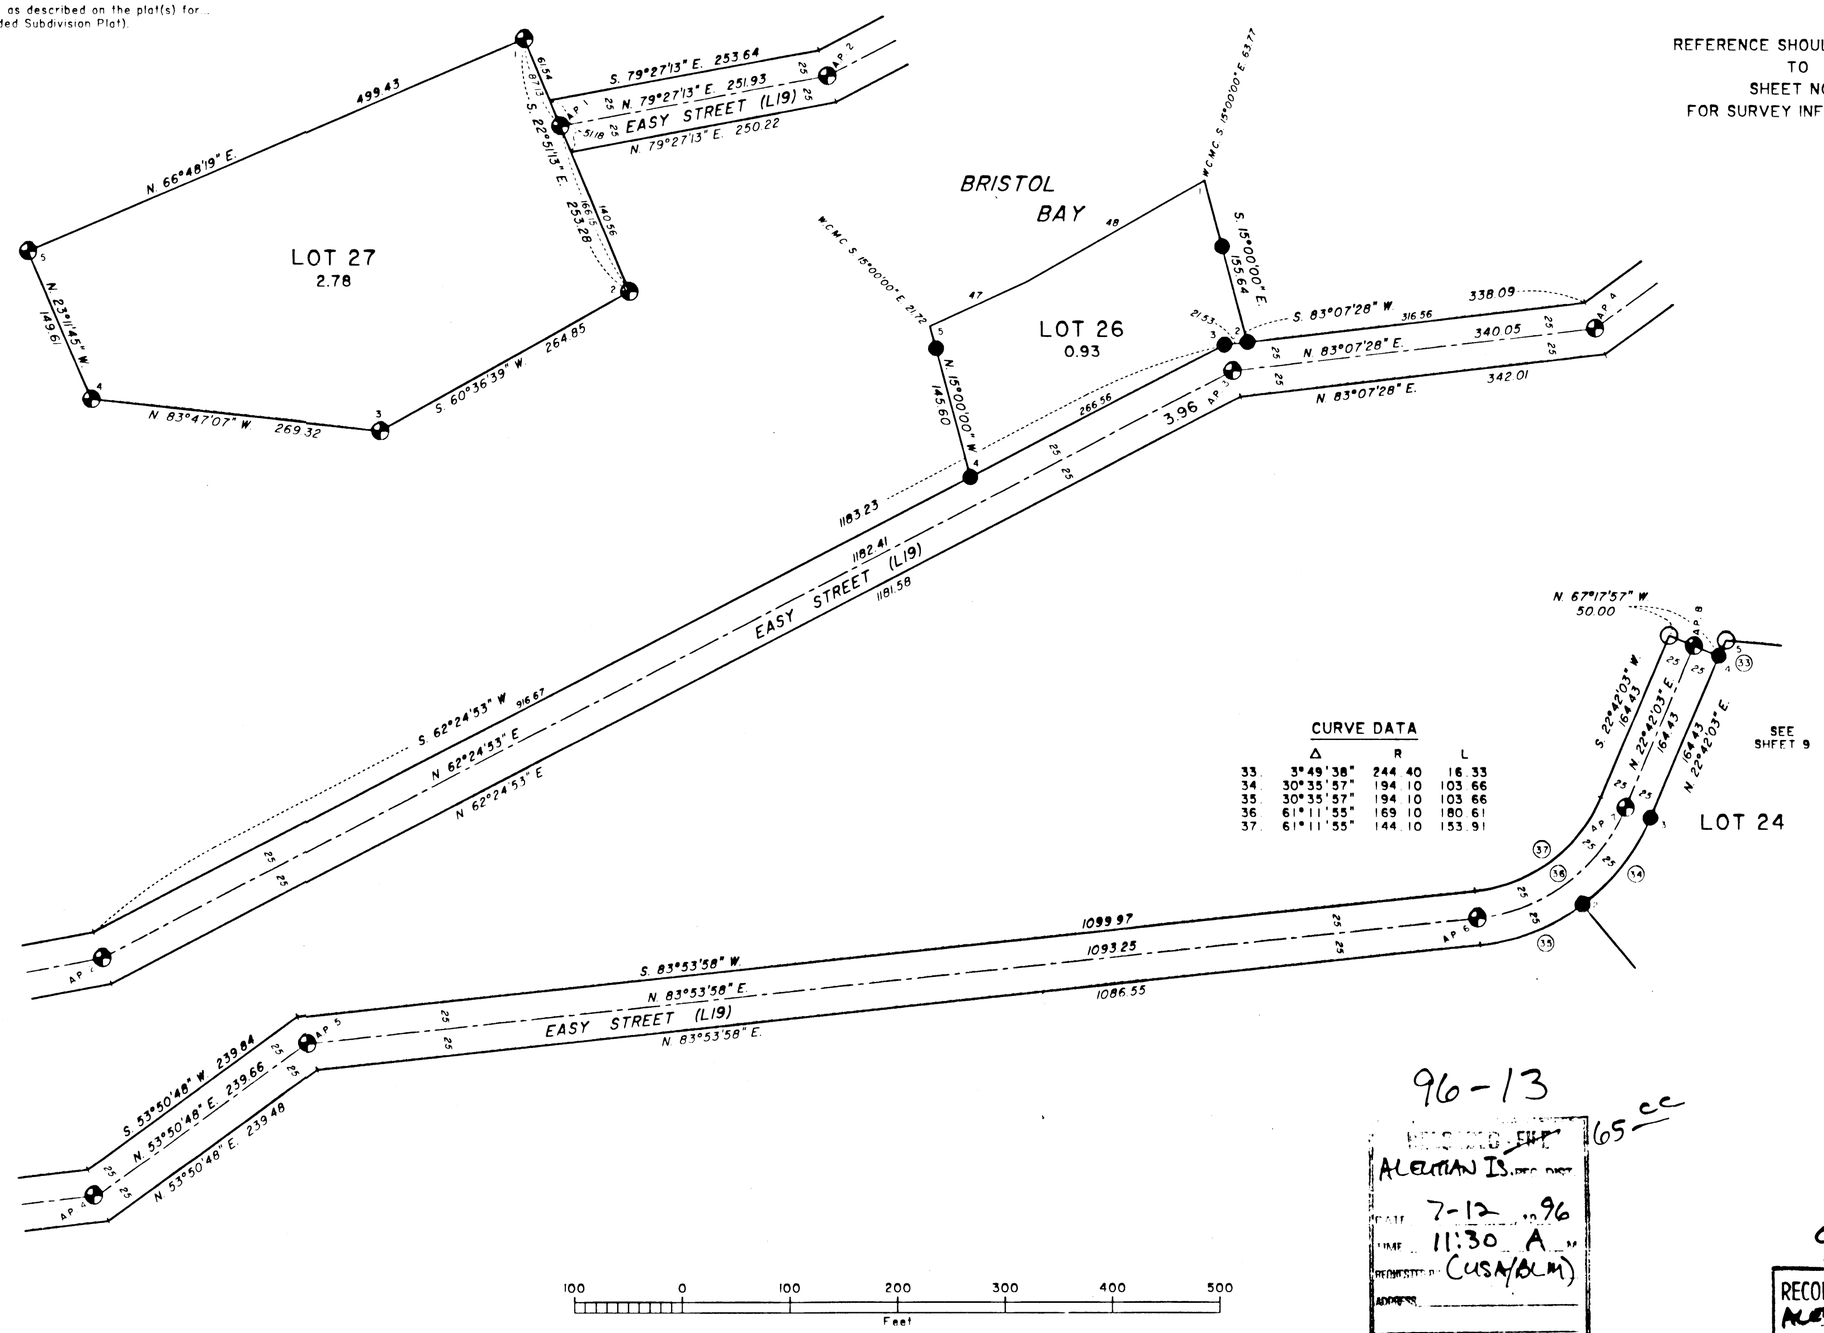

True Meridian

Mean Magnetic Declination 18° E.

100 0 100 200 300 400 500
Feet

96-13

RECORDED - FILED 65 cc
ALEUTIAN IS. REC. DIST.
DATE 7-12 19 96
TIME 11:30 A M
REQUESTED BY (USA/BLM)
ADDRESS

92-24

RECORDED - FILED 65 cc
ALEUTIAN IS. REC. DIST.
DATE 6-16 19 92
TIME 10:30 A M
REQUESTED BY (USA/BLM)
ADDRESS

COPY

RJC

96-13
Aleutian Islands